


Claim of Beneficial Use - Noble Farms

Application G-18318, Permit G-17814

Township 3S, Range 4E, W.M.

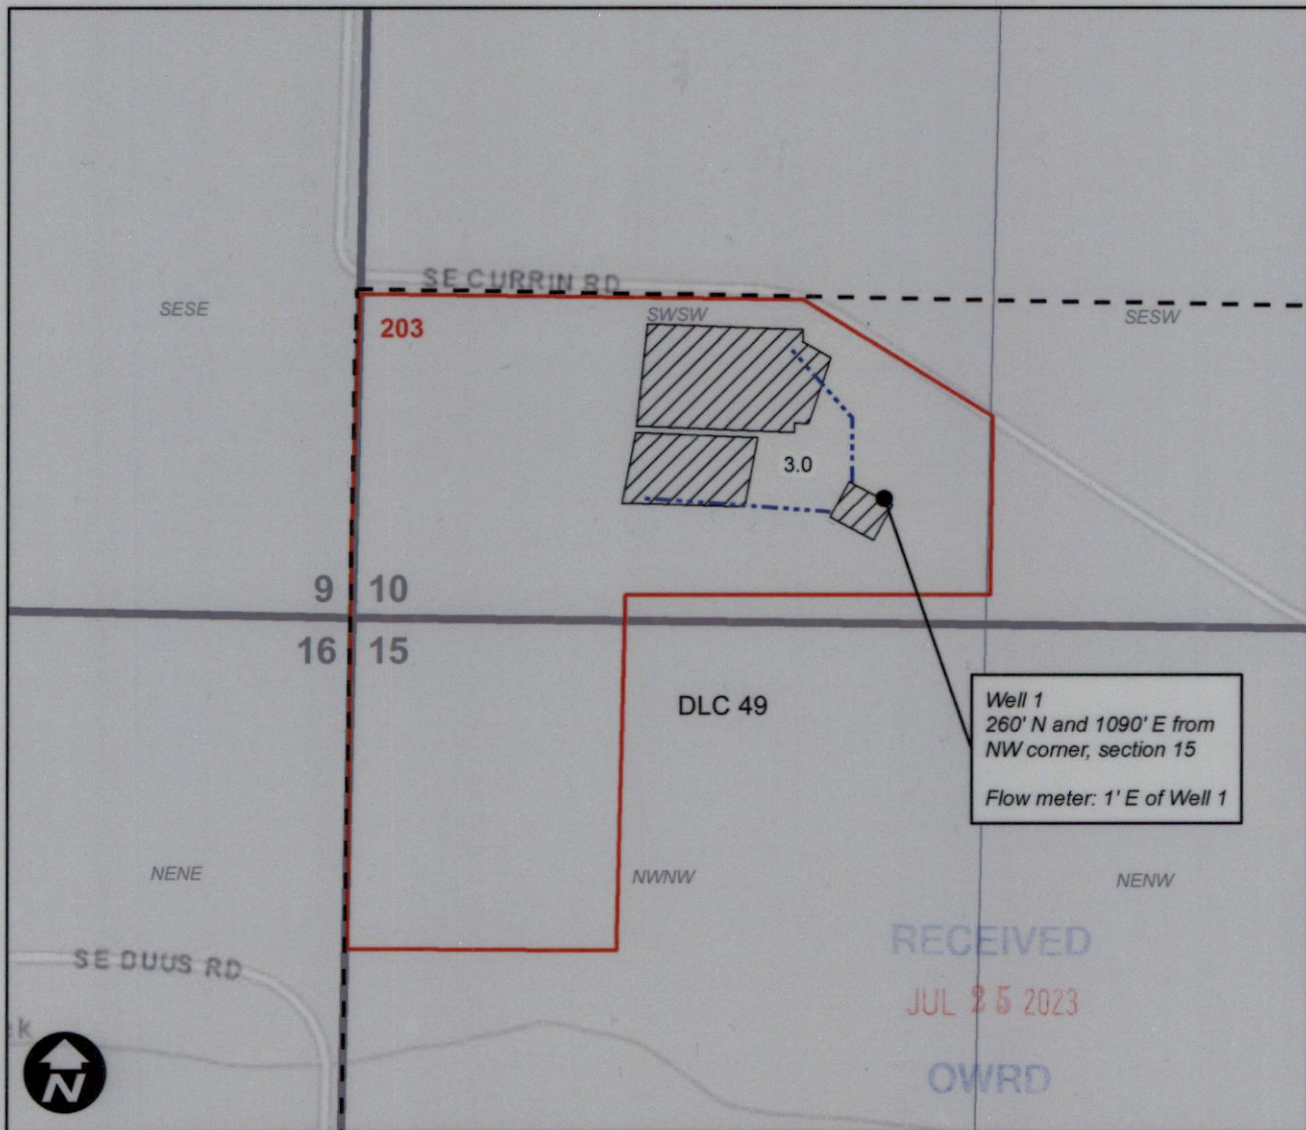

This map is not intended to provide legal dimensions or locations of property ownership lines.

0 200 400 800 Feet

Legend

- Developed POU
- Taxlot
- Mainline
- DLC

