



T18S R1W, WM

LANE COUNTY

**John M &
Mary Ann
Stewart
Warner
DLC 39**

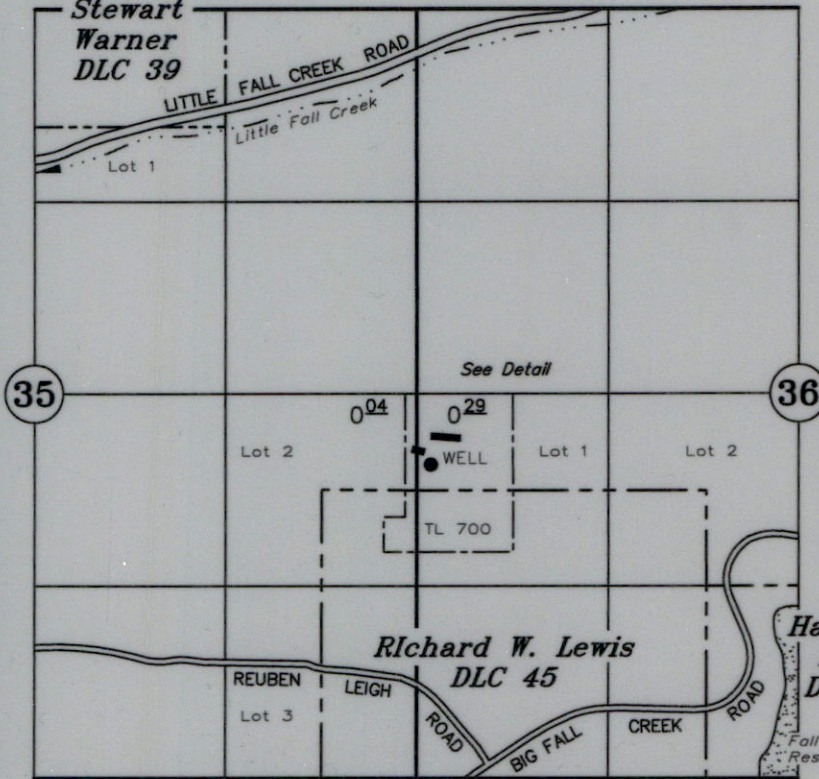

1/4 COR

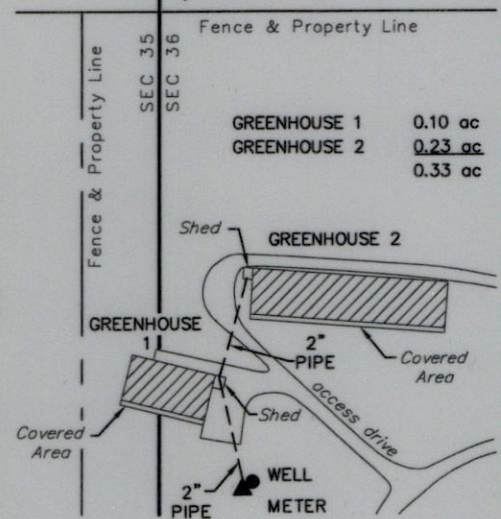

Detail

Scale: 1" = 200'

TAX LOT: 18 1W 36 700

▲ METER

● WELL

----- DLC LINE

----- TAX LOT LINE

▨ IRRIGATED AREA

WELL: 488' SOUTH AND 98' EAST FROM THE W 1/4 CORNER SEC 36

METER: 493' SOUTH AND 95' EAST FROM THE W 1/4 CORNER SEC 36

CLAIM OF BENEFICIAL USE


Application No. G-18337

Permit No. G-17863

GRATEFUL GREENERY

September 27, 2023

SCALE: 1" = 1320'

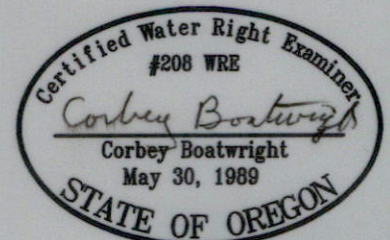

NOTE: This map is for the purpose of identifying the location of water rights and has no intent to dimension or locate property ownership lines.

Renews: December 31, 2023

RECEIVED
DEC 11 2023
OWRD