


T.6S. R.3W. Section 23, W.M.

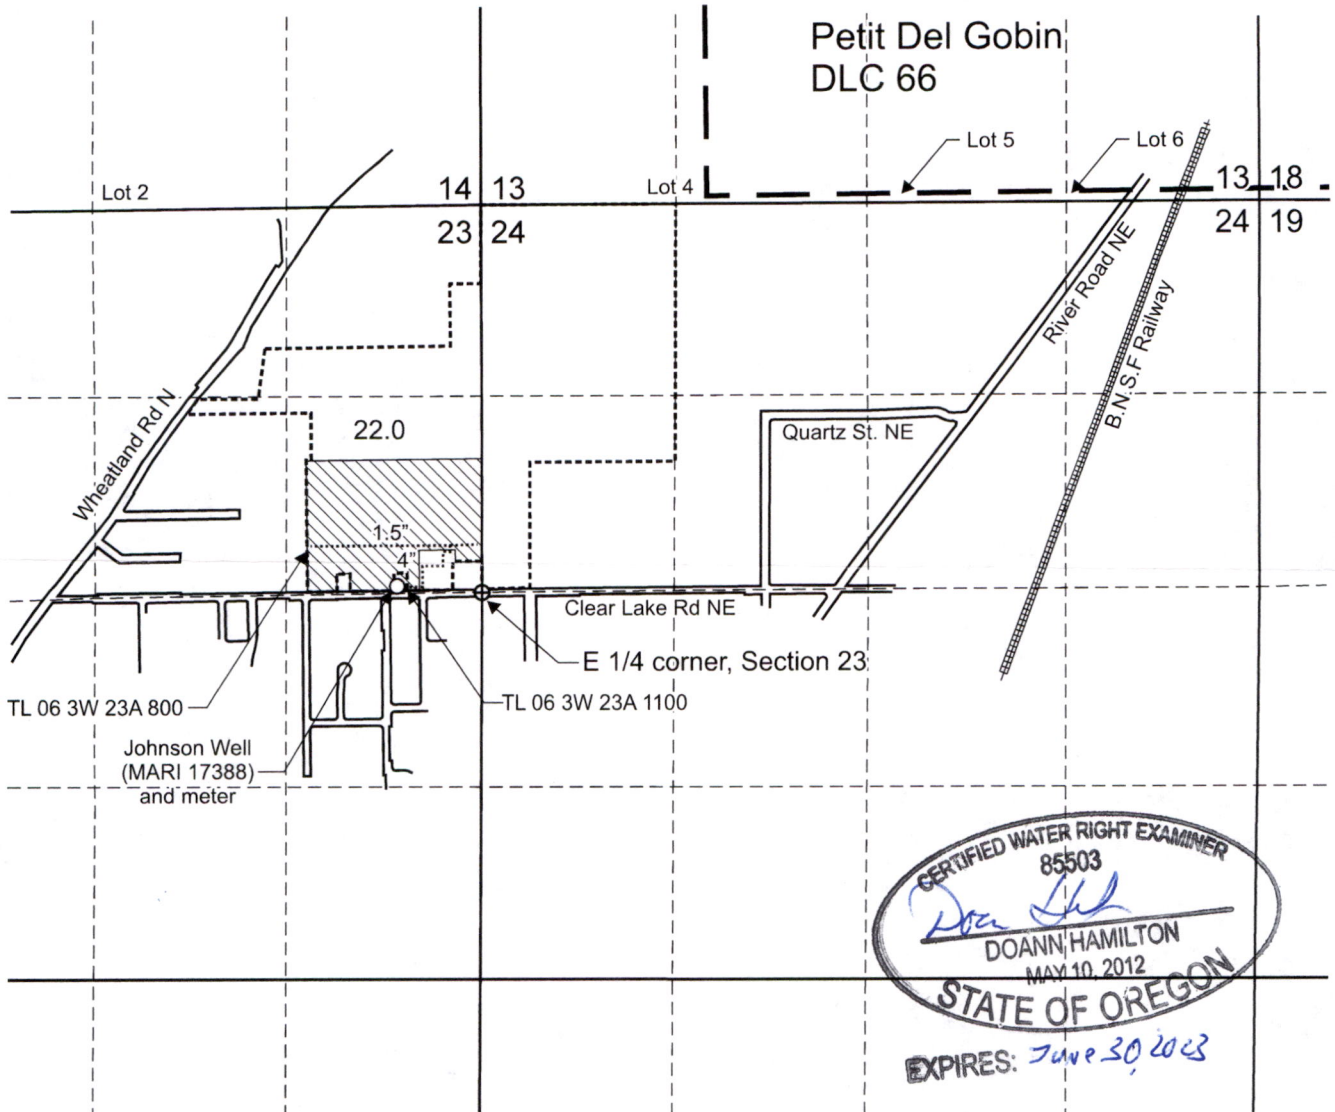


Johnson Well (MARI 17388) is located 40 feet north and 580 feet west from the E 1/4 corner, Section 23.

 Area (22.0 Acres) irrigated under Application G-18341, Permit G-17828.

- Tax lot boundary
- ■ — Donation Land Claim boundary
- Irrigation main line

Scale: 1" = 1,320'

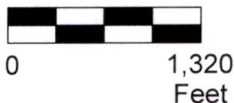

This map was prepared for the purpose of identifying the location of a water right only and is not intended to provide legal dimensions or location of property ownership lines.

RECEIVED

JUN 16 2022

OWRD

Claim of Beneficial Use Map
Application G-18341, Permit G-17828

Clearlake Farms LLC
T.6S. R.3W. Section 23, W.M.

Pacific Hydro-Geology Inc.

06/2022