


Claim of Beneficial Use
Permit G-17870, Application G-18420

A Water Right held by Stone Age Farms, LLC
Clackamas County

- SUPERCEDING
CLAIM MAP -

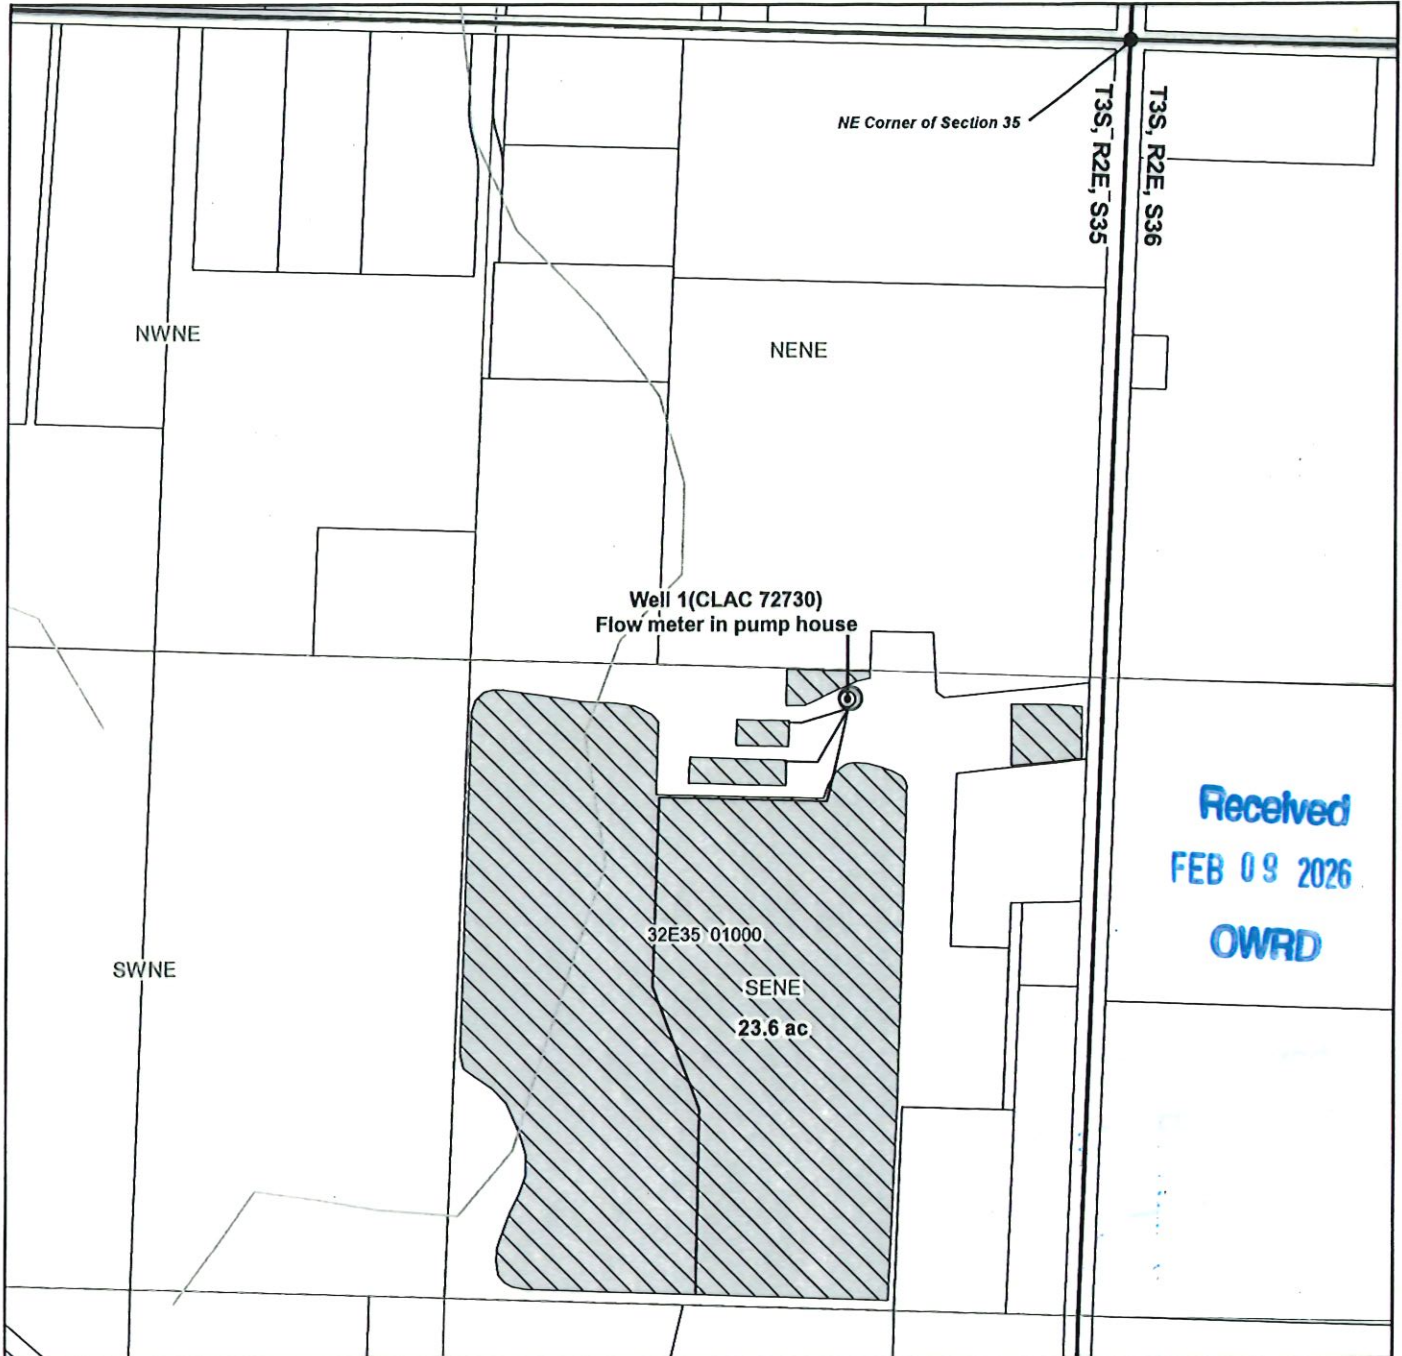

Received
FEB 09 2026
OWRD

LEGEND

- ⊙ Point of Appropriation (POA)
- ▨ Place of Use (POU)
- Storage Tank
- Property Lines
- ~ Streams
- ~ Conveyance Mains

POA Location Description

Well 1 (CLAC 72730, L-124953)
Located 1,380 feet South and 550 feet West from NE corner
of Section 35, Township 3 South, Range 2 East, W.M.



RENEWS: 12-31-2024

CWRE Seal and Signature



Date: 5/5/2023
Data Sources: BLM, OWRD, ODFW, USGS, Clackamas County.
Disclaimer: This map is not intended to provide legal dimensions
or property ownership lines.