



JOSEPHINE COUNTY OREGON

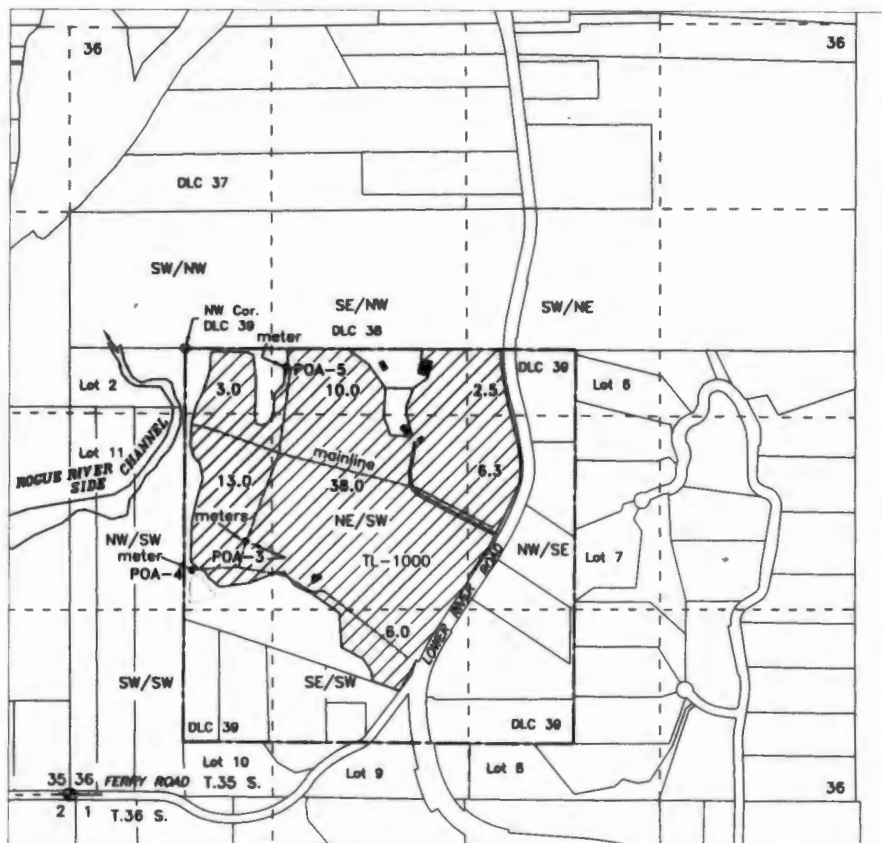

NORTH


OWRD

POA-5, WELL L-139684 - SE/NW, DLC 39, 130 feet South & 680 feet East from NW Corner DLC 39

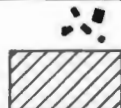

- Drilled Wells

Hoellrich Rev. Trust
100 Ferry Road
Grants Pass, OR 97526

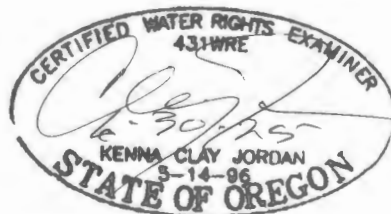
$$1'' = 1320'$$

10/23/2023 ned

Base map Josephine County GIS tax lots over 1/19/21
Oregon Map aerial photo, 10/26/20 Google aerial photo, & FPS
Map for Permit G-6479 for assumed best fit. Map oriented
and scaled to Survey Map 146-76

This map is not intended to provide legal dimensions or locations of property ownership lines