


**APPLICATION FOR CONSERVATION USE MAP
FOR: CONFLUENCE ESTATE
BY: NATHAN R. REED
T25S, R7W, W.M. SECTION 25, DLC 37
CERTIFICATE NO. 53700
CERTIFICATE NO. 79749**

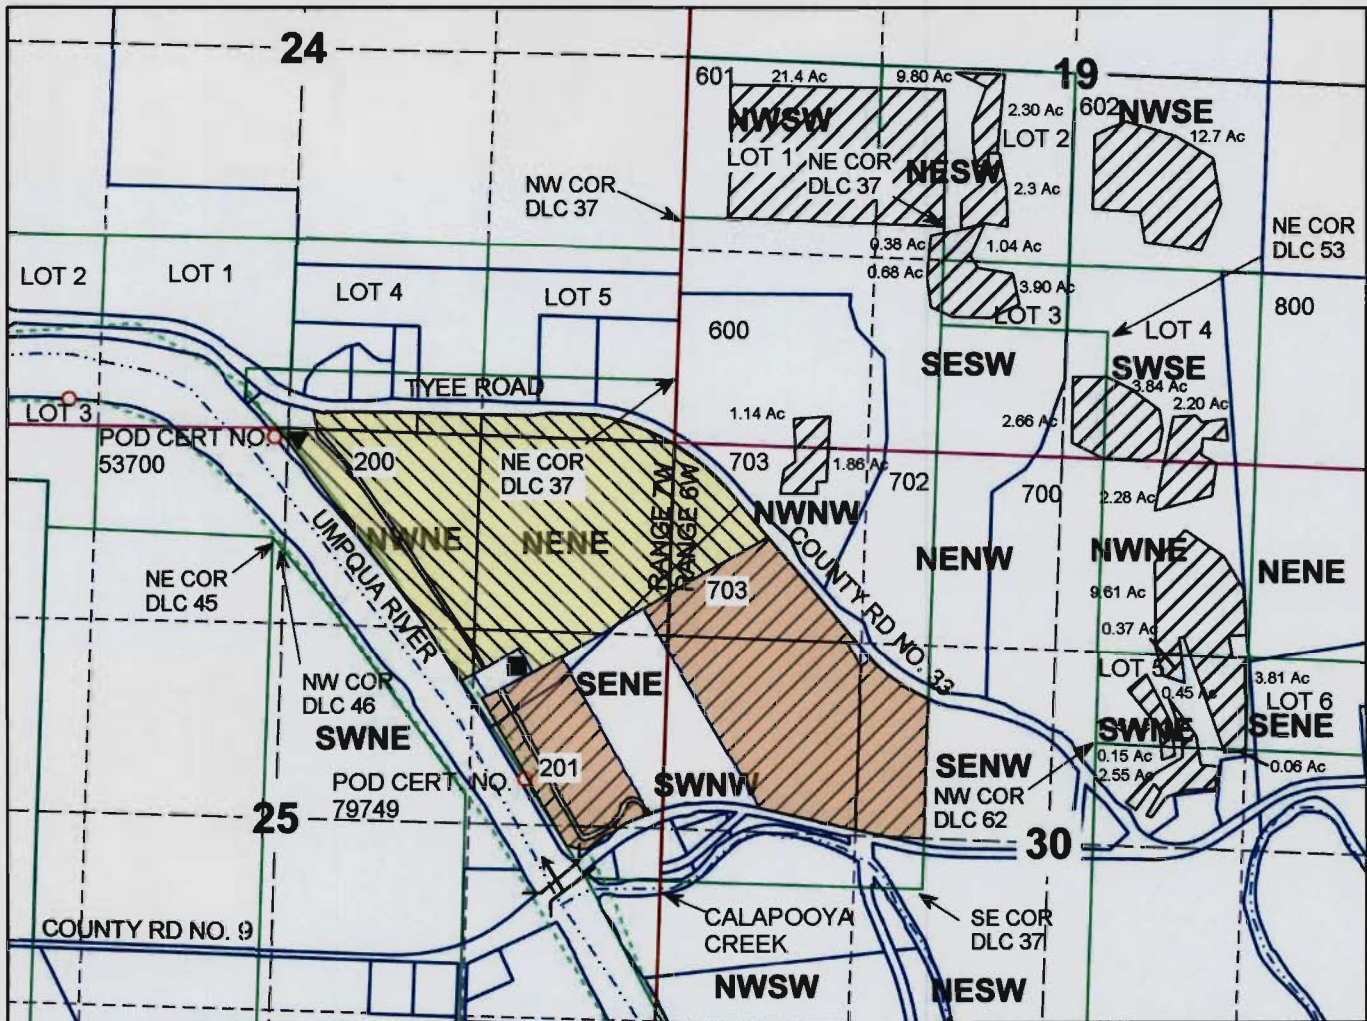

Scale: 1" = 1320'

POD CERTIFICATE NO. 53700 LOCATED 2630 FEET NORTH AND 36 FEET WEST FROM THE CENTER OF SECTION 25
POD CERTIFICATE NO. 79749 LOCATED 250 FEET NORTH AND 1690 FEET EAST FROM THE CENTER OF SECTION 25



Legend

	Roads		Gov_Lot
	structure		Township
	POD		DLC
	PUMP		Section
	Stream		Quarter
	Flow_arrow		Sixteenth
	Meander		Parcels

RECEIVED BY OWRD

AUG 21 2013


SALEM, OR

T	R	Sec	QQ	GLot	DLC	Ac
25S	6W	19	NWSW	1		21.4
25S	6W	19	NWSE			12.7
25S	6W	19	NESW	2		15.4
25S	6W	19	NESW		37	0.38
25S	6W	19	SESW		37	0.68
25S	6W	19	SESW	3		3.90
25S	6W	19	SWSE		53	7.66
25S	6W	19	SWSE	4		6.04
25S	6W	19	SWSW		37	1.14
25S	6W	30	NWNE	4		11.9
25S	6W	30	SWNE	5		6.21
25S	6W	30	SWNE		62	2.76
25S	6W	30	NWNW		37	1.86

92.03 PROPOSED

THE PURPOSE OF THIS MAP IS TO IDENTIFY THE LOCATION OF THE WATER RIGHT. IT IS NOT INTENDED TO PROVIDE INFORMATION RELATIVE TO THE LOCATION OF PROPERTY OWNERSHIP BOUNDARY LINES.

MAP PREPARED BY:
NATHAN R. REED, P.E., CWRE
1113 SE CASS AV
ROSFRIURG OR 97470

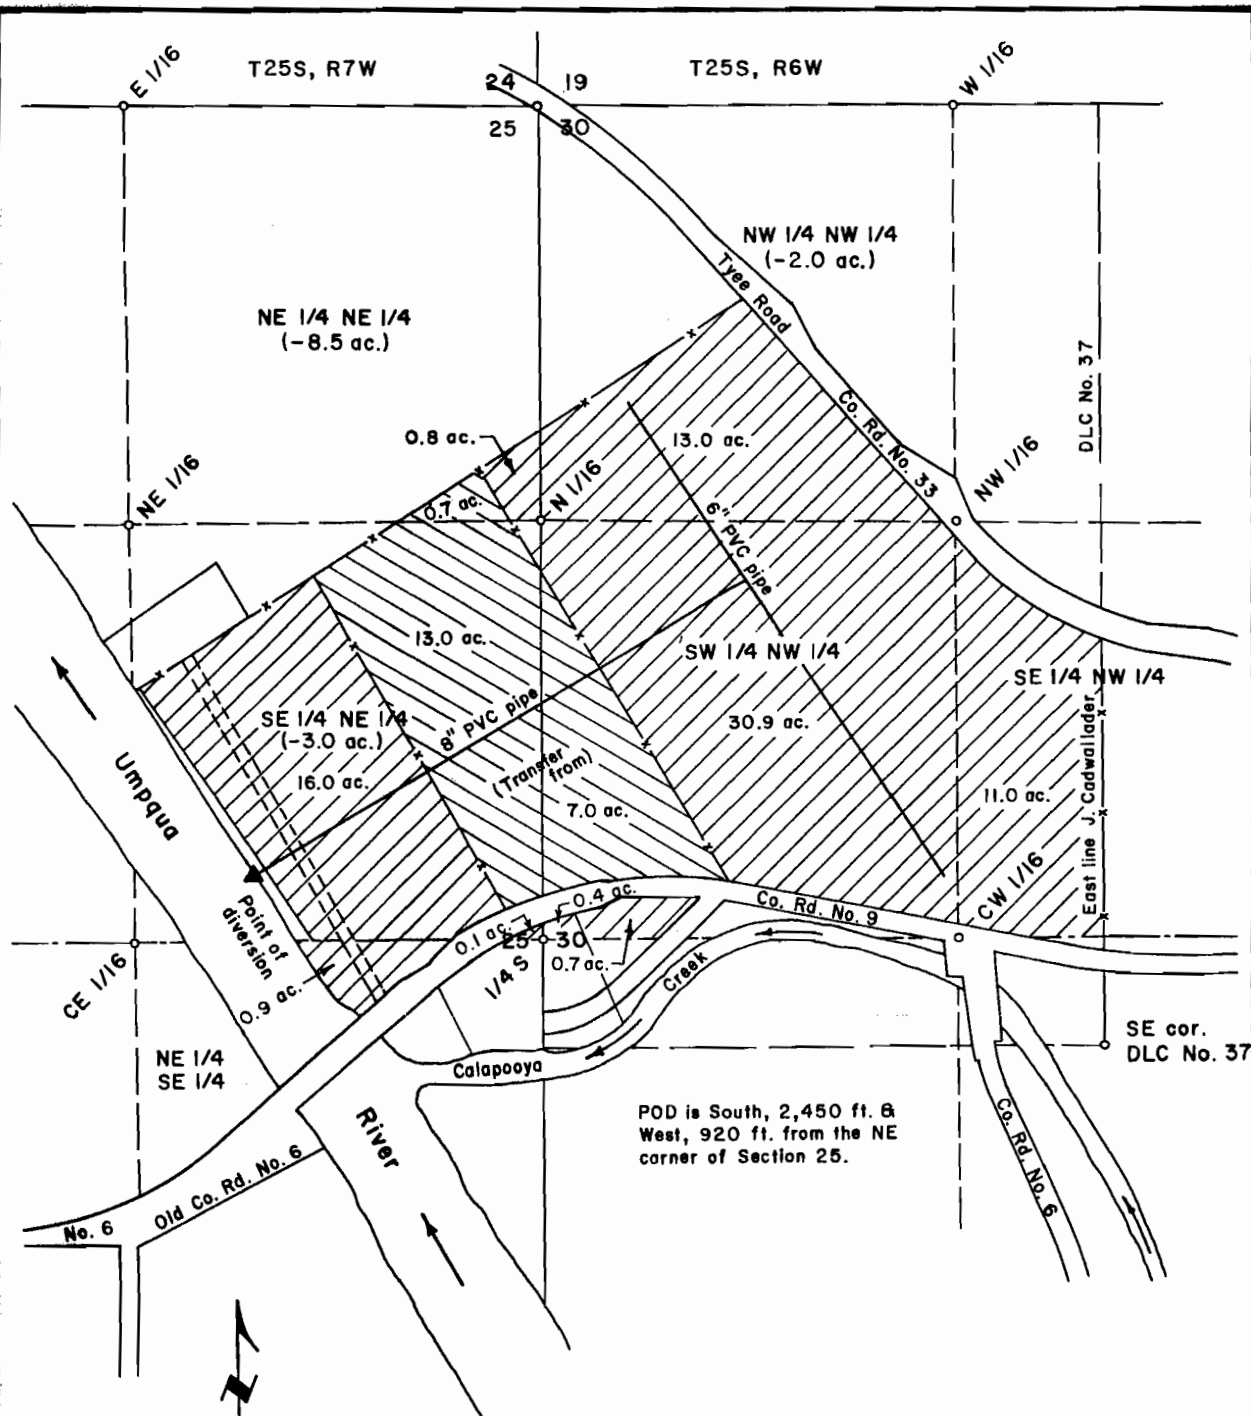


POD is South, 2,450 ft. &
West, 920 ft. from the NE
corner of Section 25.

**PARTIAL CANCELLATION OF A
WATER RIGHT CERTIFICATE IN
the J. Cadwallader Donation Land Claim No. 37 in the
NW 1/4 of Sec. 30, T25S, R6W & the E 1/2 of Sec. 25, T25S,
R7W, W.M., Douglas County, Oregon**

Permit No. 21281 Transfer No. 8826
Application No. 27043
Water Right Cert. No. 22959

For: Sam Joe Henry II &
William Dean Henry II
1827 Tyee Road
Umpqua, Oregon 97486

By: Shaner Engineering, Inc.
P.O. Box 1430
Roseburg, Oregon 97470

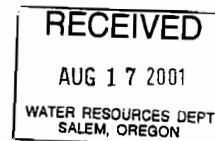


July 20, 2001

I, FRED L. DOW OF SUTHERLIN, OREGON DO HEREBY CERTIFY THAT THIS MAP WAS MADE FROM NOTES TAKEN DURING AN ACTUAL SURVEY MADE BY ME ON MARCH 2, 1952; THAT THE MONUMENT SHOWN ON THIS MAP CONSISTING OF A 1" X 36" IRON PIPE IS NORTH 210.0 FEET FROM THE SOUTHEAST CORNER OF THE J. CADWALLADER D.L.C. No. 37 IN SECTION 30, T. 25 S. R. 6 W. 1 W. M

Fred L. Dow
CIVIL ENGINEER




LLOYD J. SCONCE UMPQUA OREGON

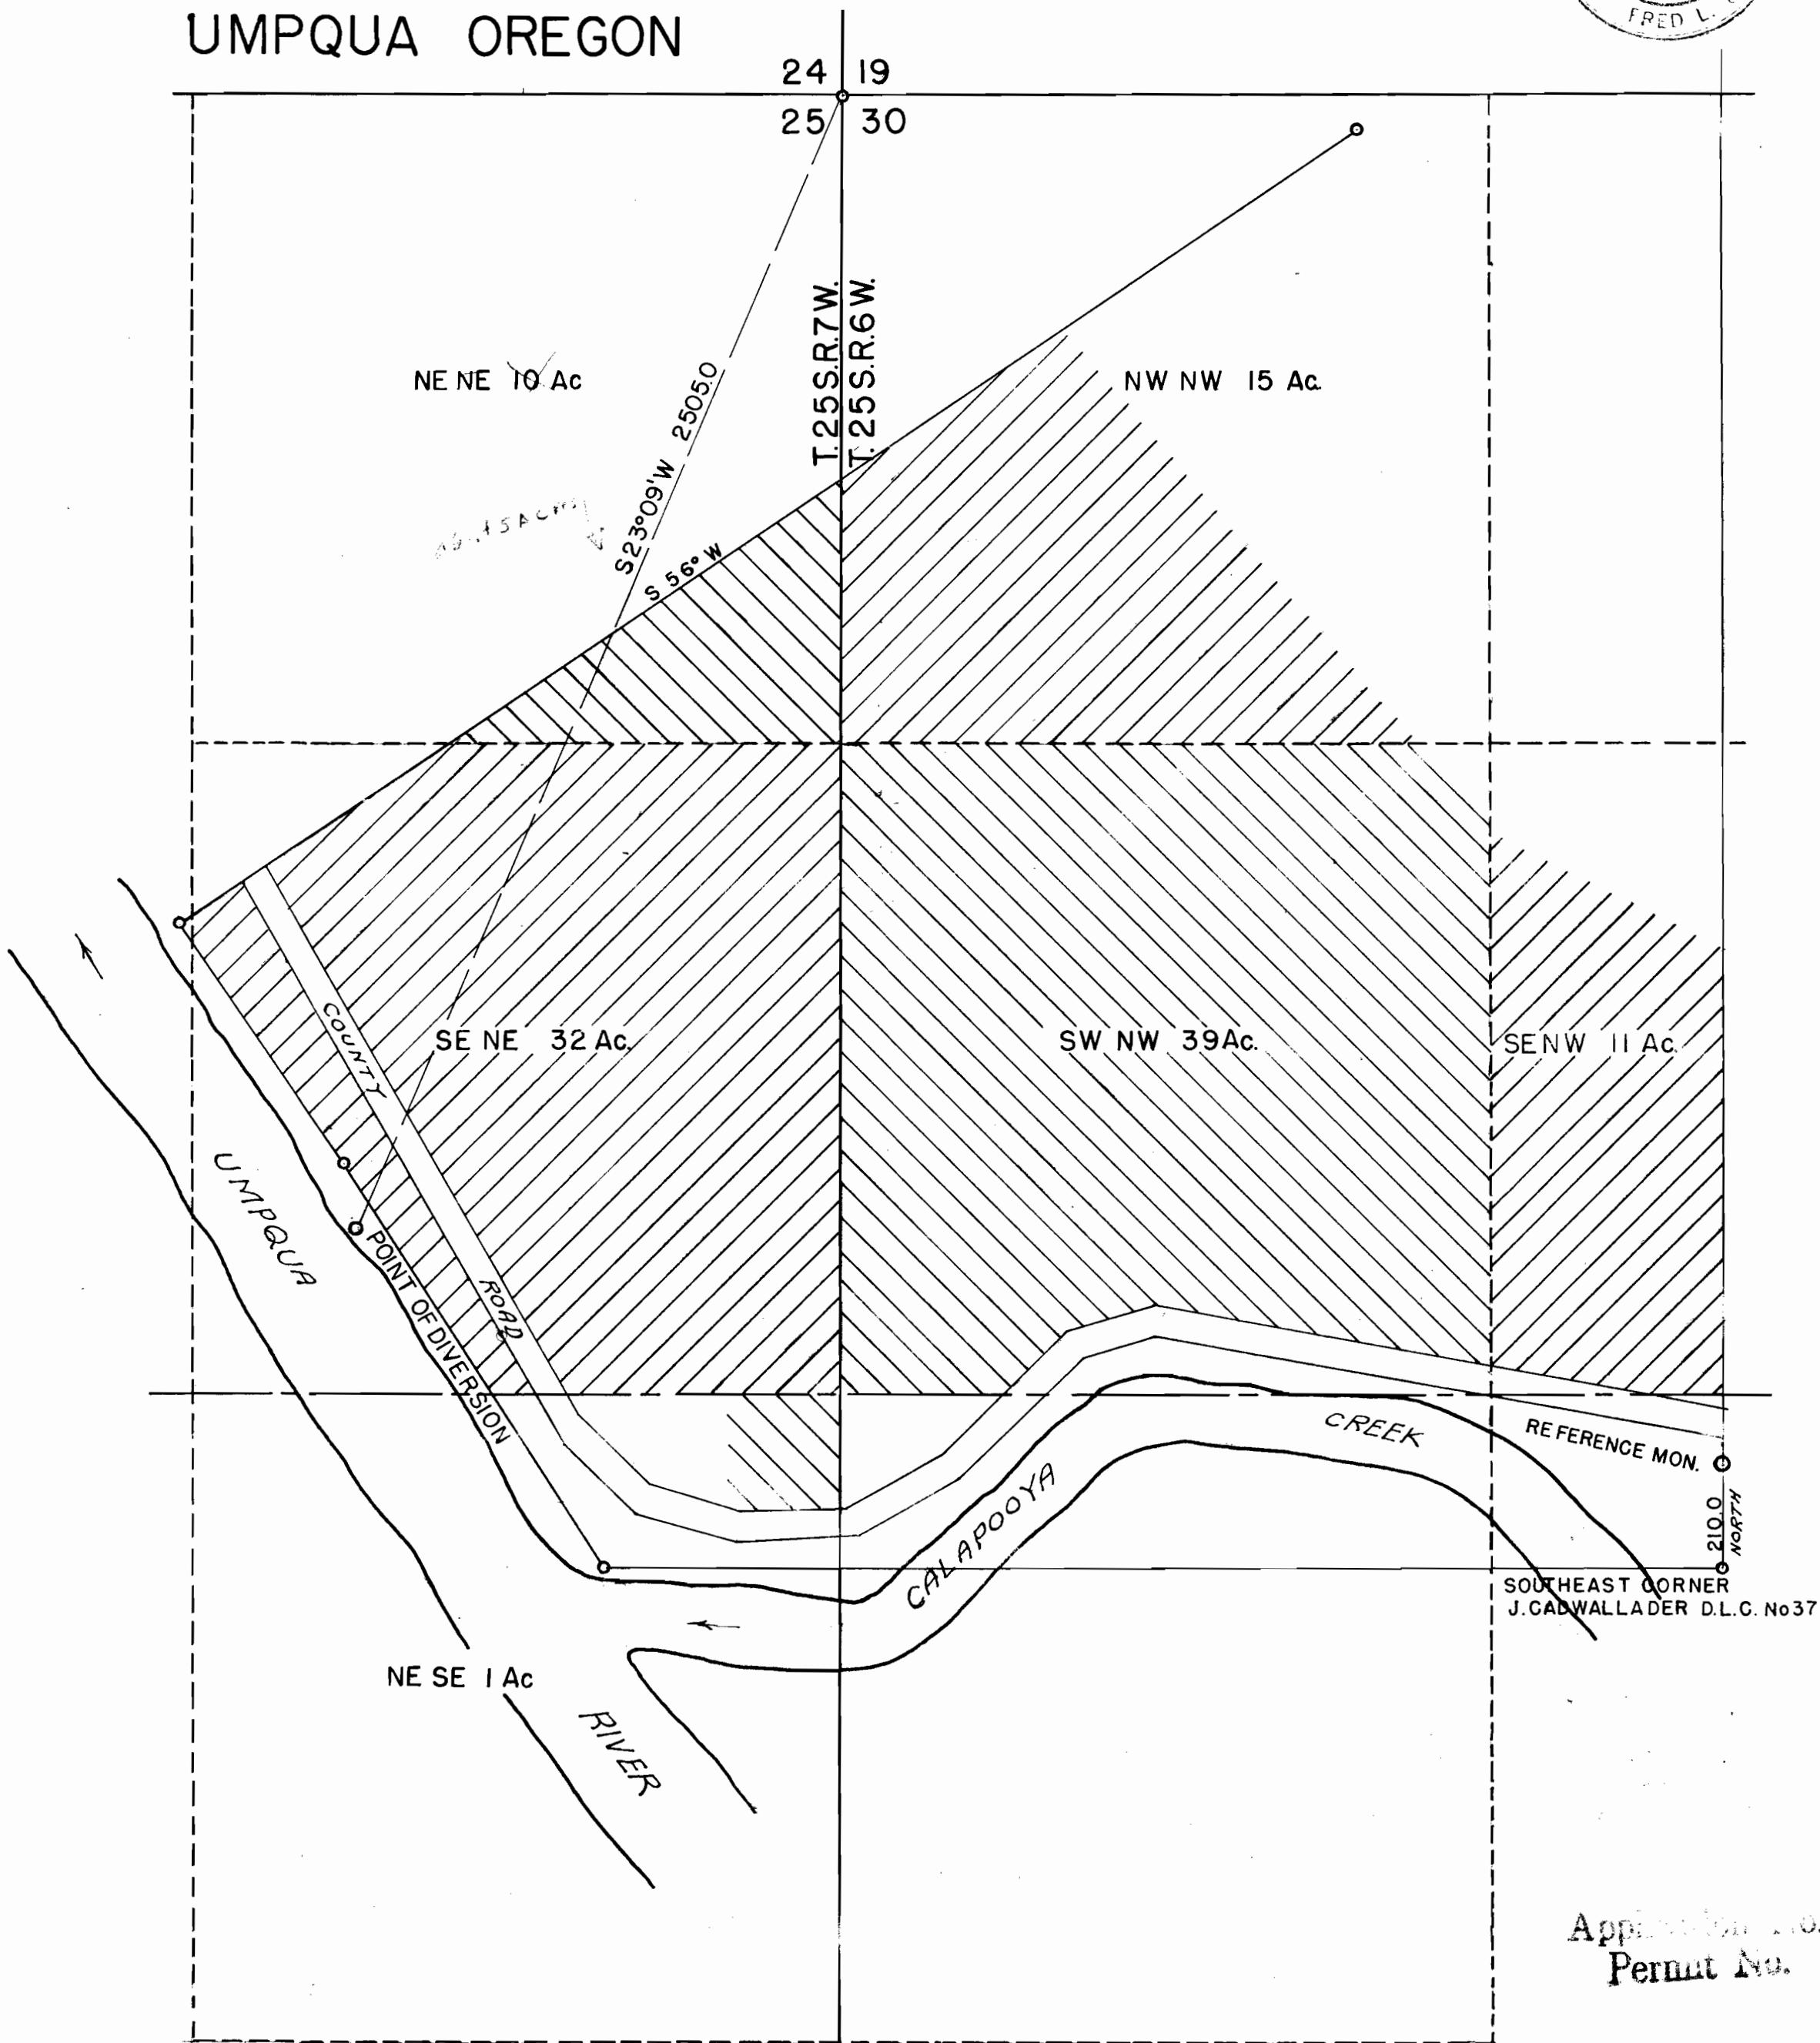

Application No. 27043
Permit No. 21281

T.25S. R.6E7W. W.M.

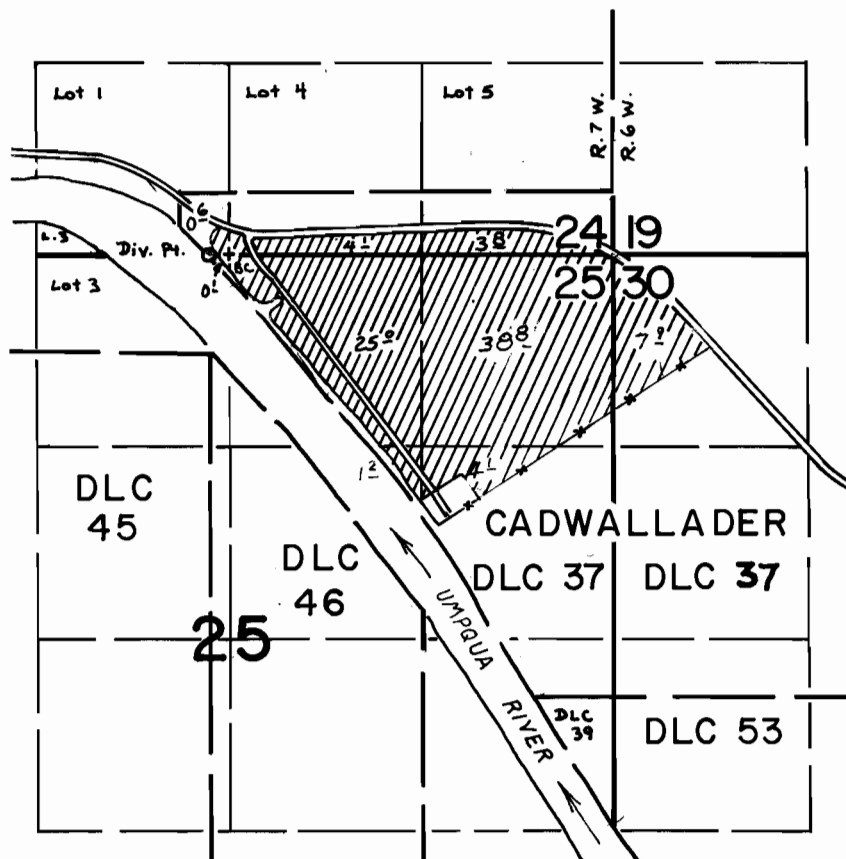

Div. Pt. Located: 120' W from N 1/4 cor. of Sec. 25

SCALE: 4" = 1 mile

FINAL PROOF SURVEY
UNDER

Application No. 51784 Permit No. 39014
IN NAME OF

James J. Busby

Surveyed July 18, 1979 by S. Donaldson