


MAP PREPARED BY:
NATHAN R. REED, P.E., CWRE
1113 SE CASS AV
ROSEBURG OR 97470

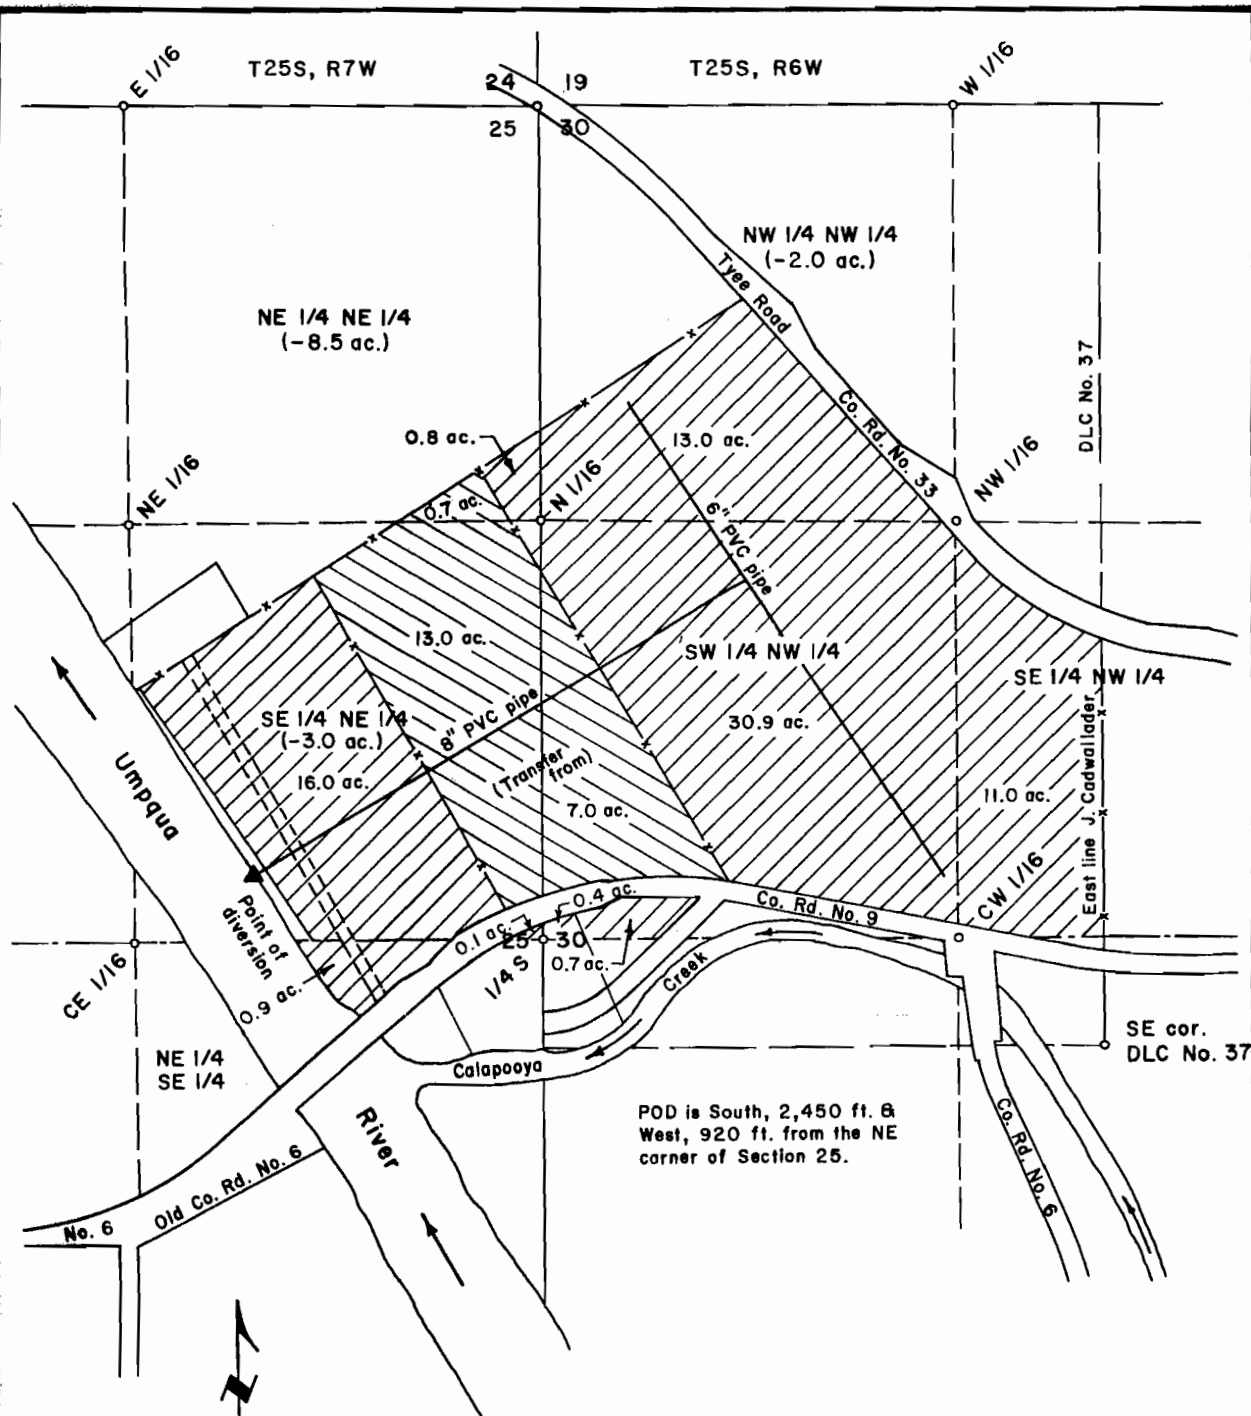


Scale: 1" = 400 ft.

**PARTIAL CANCELLATION OF A
WATER RIGHT CERTIFICATE IN
the J. Cadwallader Donation Land Claim No. 37 in the
NW 1/4 of Sec. 30, T25S, R6W & the E 1/2 of Sec. 25, T25S,
R7W, W.M., Douglas County, Oregon**

Permit No. 21281 Transfer No. 8826
Application No. 27043
Water Right Cert. No. 22959

For: Sam Joe Henry II &
William Dean Henry II
1827 Tyee Road
Umpqua, Oregon 97486

By: Shaner Engineering, Inc.
P.O. Box 1430
Roseburg, Oregon 97470

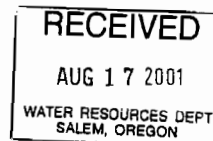


July 20, 2001

I, FRED L. DOW OF SUTHERLIN, OREGON DO HEREBY CERTIFY THAT THIS MAP WAS MADE FROM NOTES TAKEN DURING AN ACTUAL SURVEY MADE BY ME ON MARCH 2, 1952; THAT THE MONUMENT SHOWN ON THIS MAP CONSISTING OF A 1" X 36" IRON PIPE IS NORTH 210.0 FEET FROM THE SOUTHEAST CORNER OF THE J. CADWALLADER D.L.C. No. 37 IN SECTION 30, T. 25 S. R. 6 W. 1 W. M

Fred L. Dow
CIVIL ENGINEER



LLOYD J. SCONCE UMPQUA OREGON

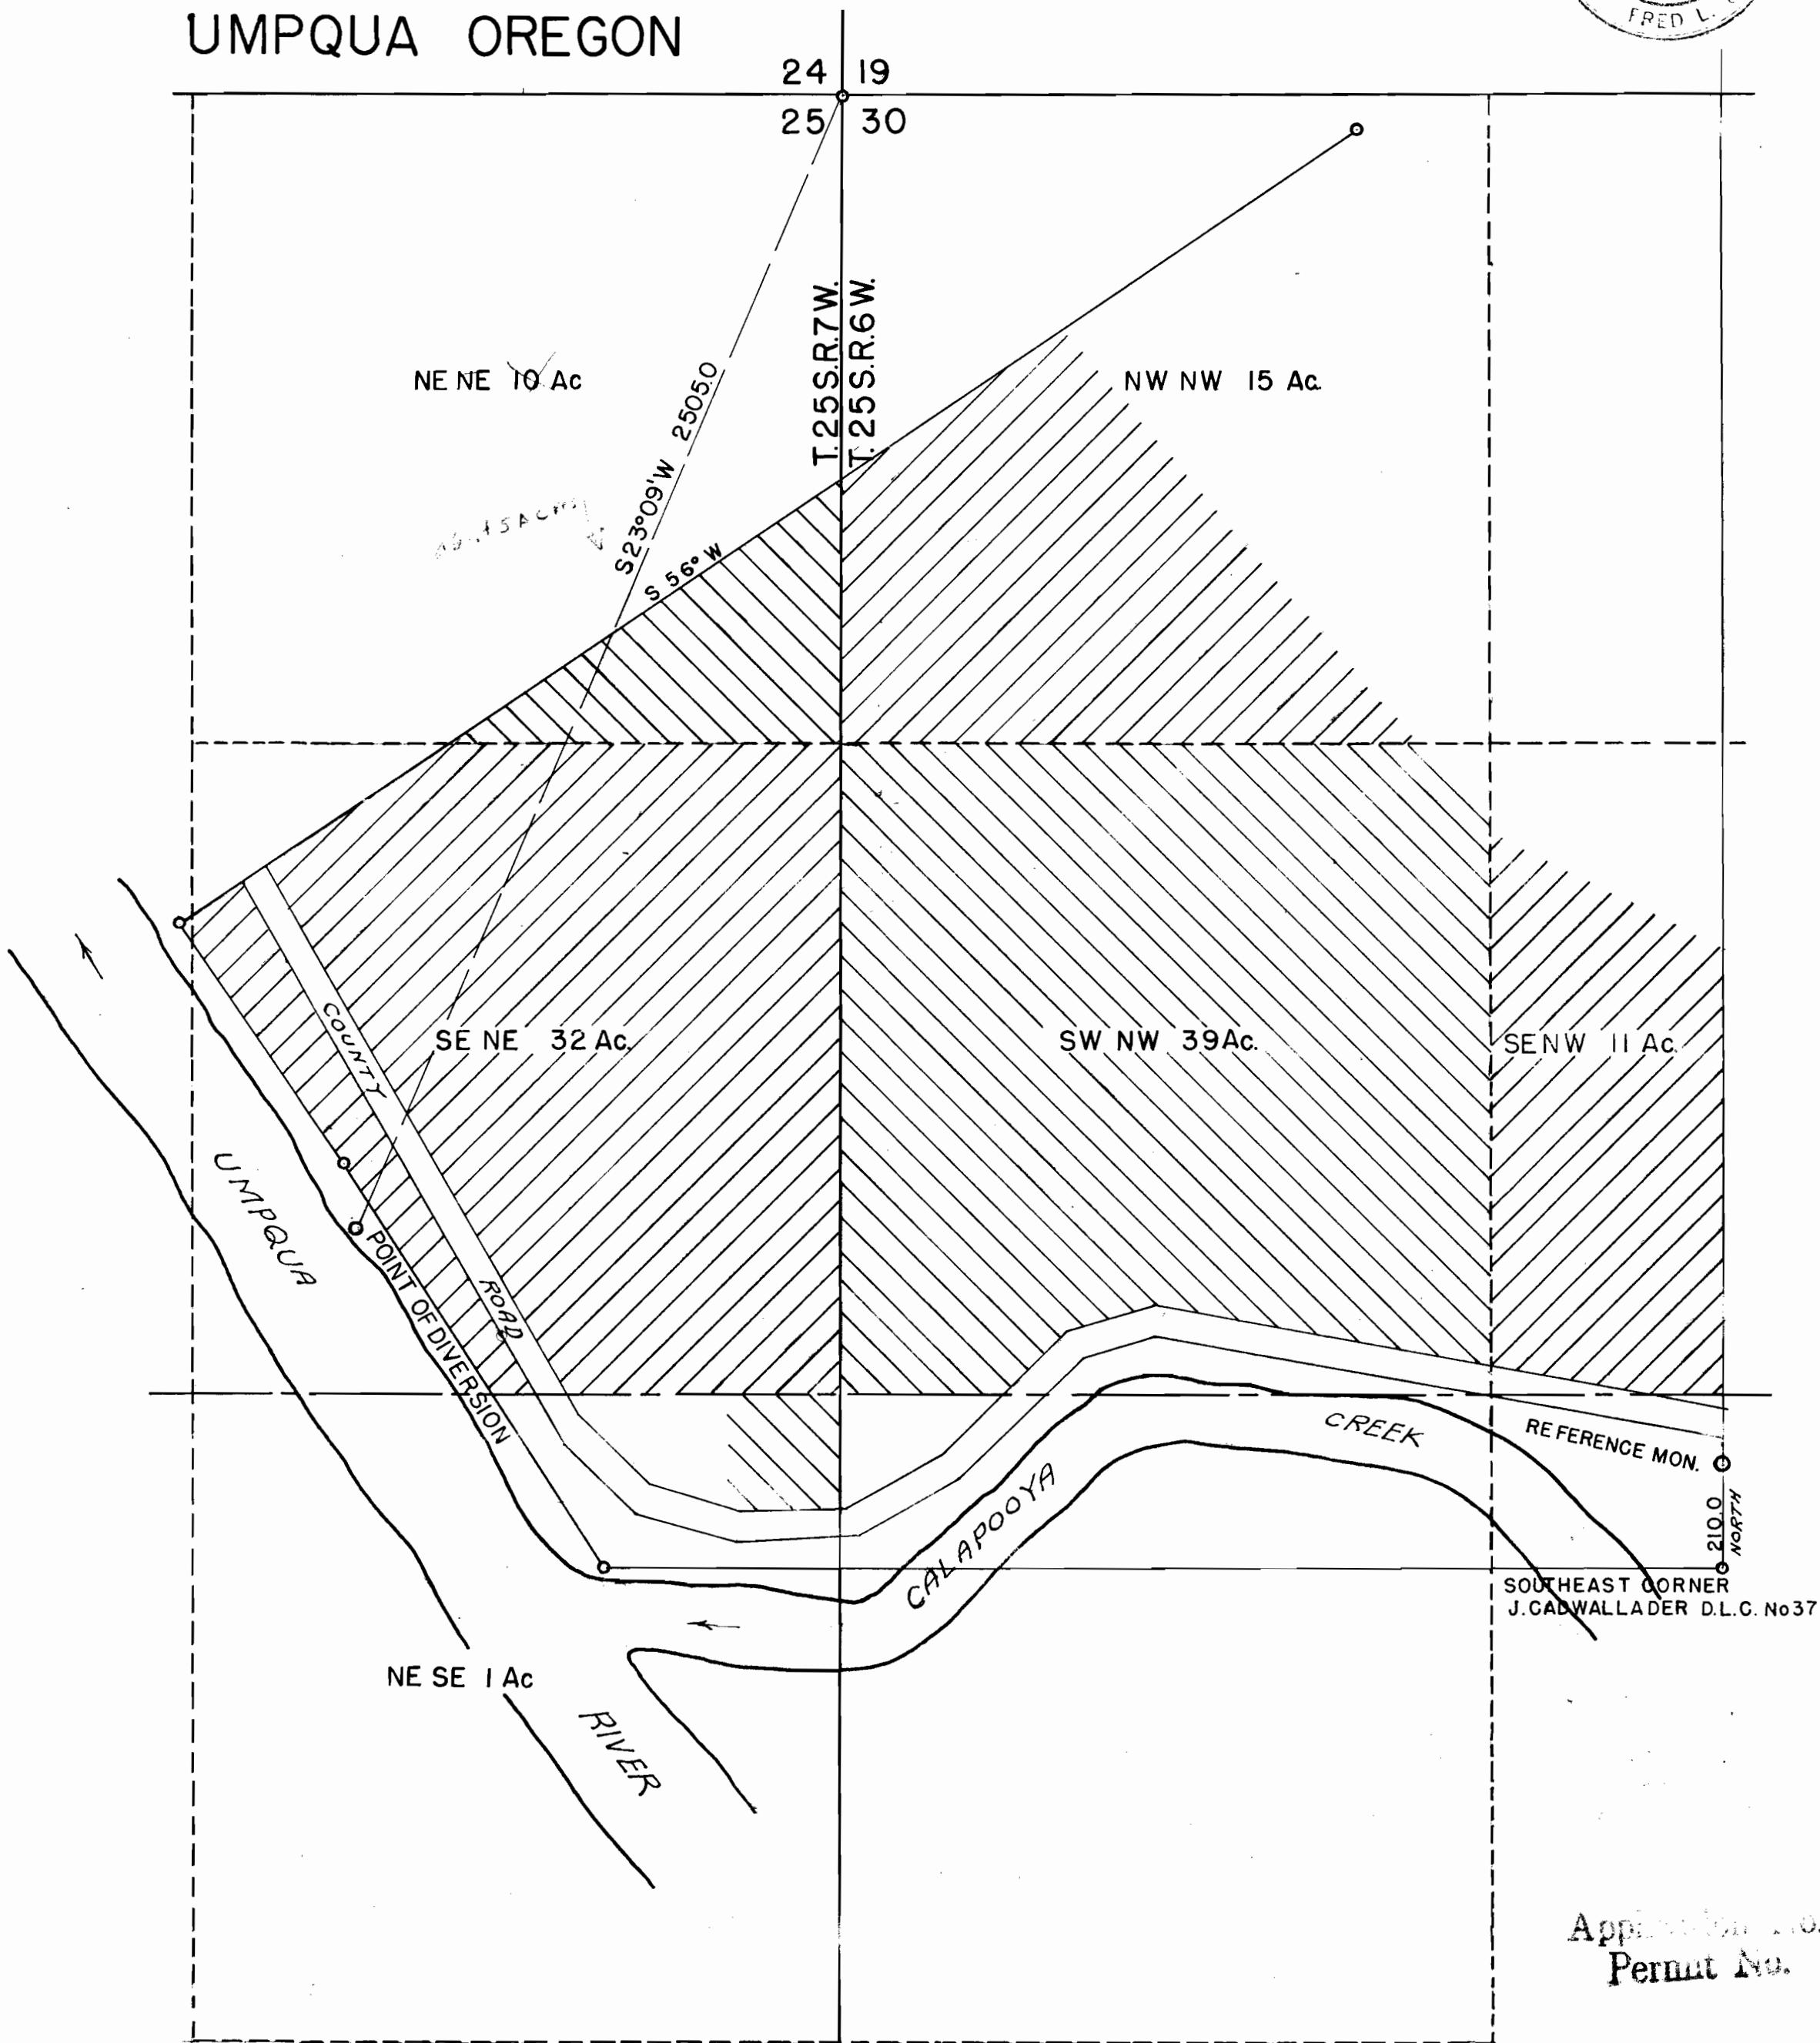

Application No. 27043
Permit No. 21281