

APPLICATION FOR CONSERVATION USE MAP

FOR: CONFLUENCE ESTATE

BY: NATHAN R. REED

T25S, R7W, W.M. SECTION 25, DLC 37


CERTIFICATE NO. 53700

CERTIFICATE NO. 79749



Scale: 1" = 1320'

POD CERTIFICATE NO. 53700 LOCATED 2630 FEET NORTH AND 36 FEET WEST FROM THE CENTER OF SECTION 25
POD CERTIFICATE NO. 79749 LOCATED 250 FEET NORTH AND 1690 FEET EAST FROM THE CENTER OF SECTION 25

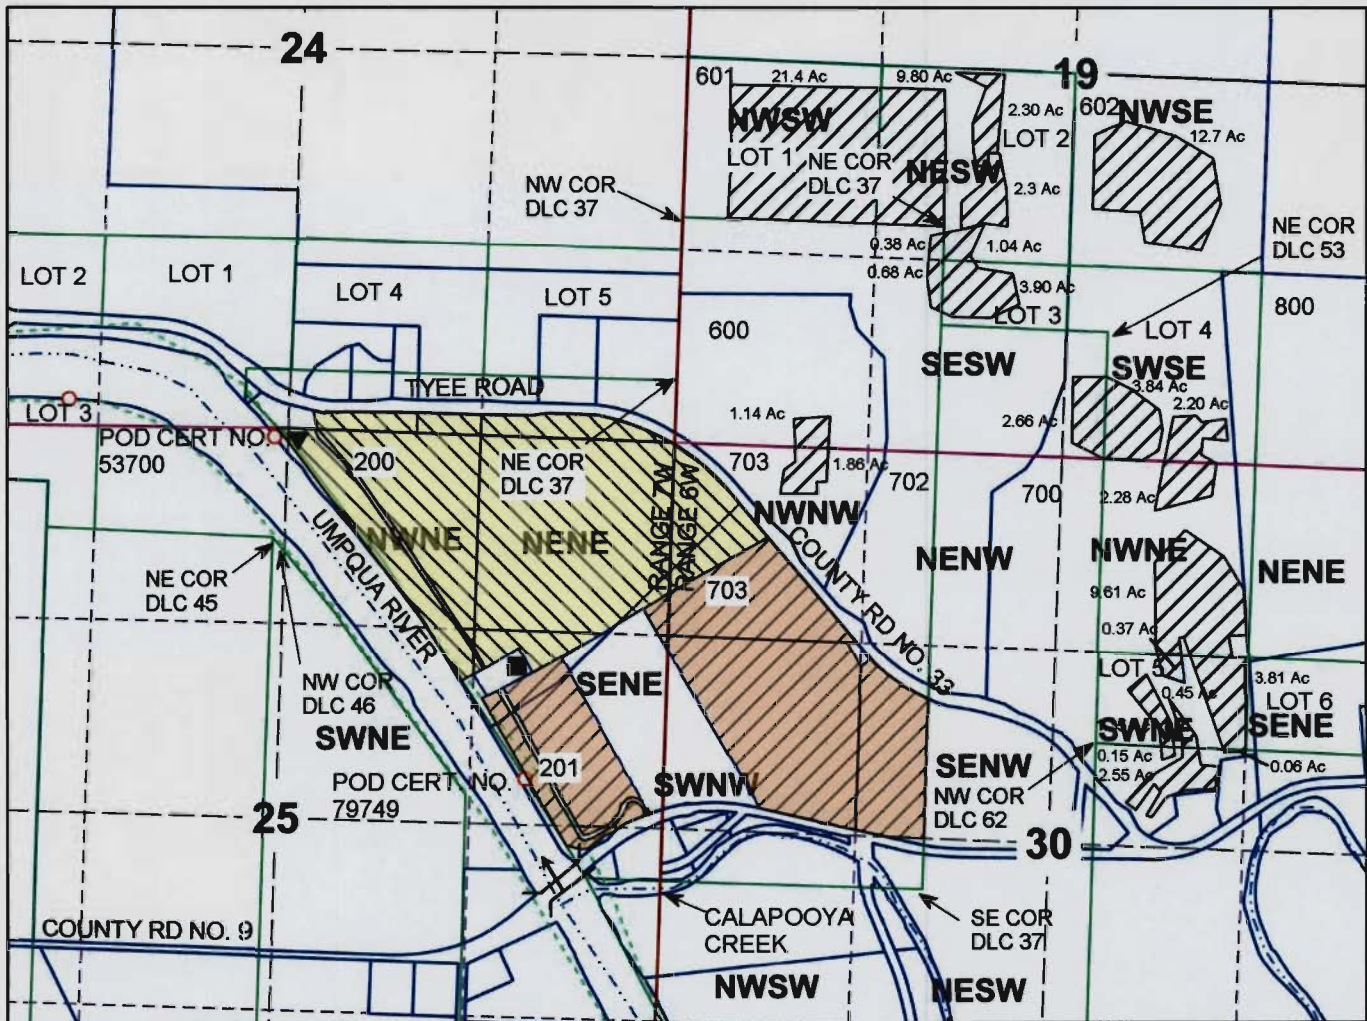

Legend

	Roads		Gov_Lot
	structure		Township
	POD		DLC
	PUMP		Section
	Stream		Quarter
	Flow_arrow		Sixteenth
	Meander		Parcels

RECEIVED BY OWRD

AUG 21 2013

SALEM, OR


T	R	Sec	QQ	GLot	DLC	Ac
25S	6W	19	NWSW	1		21.4
25S	6W	19	NWSE			12.7
25S	6W	19	NESW	2		15.4
25S	6W	19	NESW		37	0.38
25S	6W	19	SESW		37	0.68
25S	6W	19	SESW	3		3.90
25S	6W	19	SWSE		53	7.66
25S	6W	19	SWSE	4		6.04
25S	6W	19	SWSW		37	1.14
25S	6W	30	NWNE	4		11.9
25S	6W	30	SWNE	5		6.21
25S	6W	30	SWNE		62	2.76
25S	6W	30	NWNW		37	1.86

92.03 PROPOSED

THE PURPOSE OF THIS MAP IS TO IDENTIFY THE LOCATION OF THE WATER RIGHT. IT IS NOT INTENDED TO PROVIDE INFORMATION RELATIVE TO THE LOCATION OF PROPERTY OWNERSHIP BOUNDARY LINES.

MAP PREPARED BY:
NATHAN R. REED, P.E., CWRE
1113 SE CASS AV
ROSFRIIRG OR 97470

T.25S. R.6E7W. W.M.

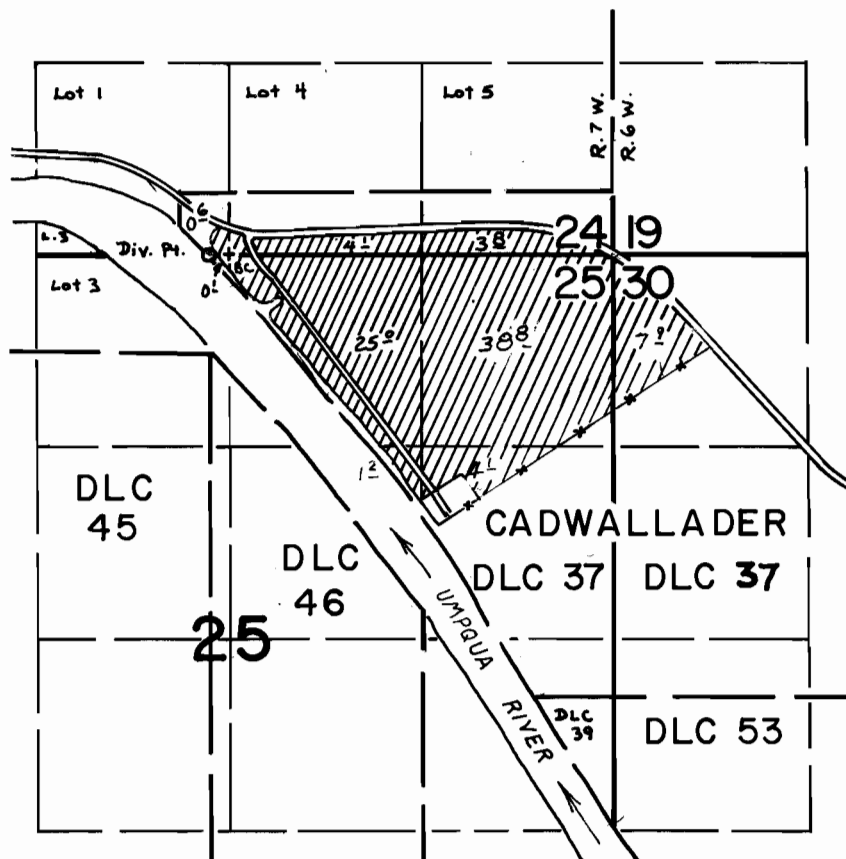

Div. Pt. Located: 120' W from N $\frac{1}{4}$ cor. of Sec. 25

SCALE: 4" = 1 mile

FINAL PROOF SURVEY
UNDER

Application No. 51784 Permit No. 39014
IN NAME OF

James J. Busby

Surveyed July 18, 1979 by S. Donaldson