


TOWNSHIP 1 SOUTH RANGE 43 EAST

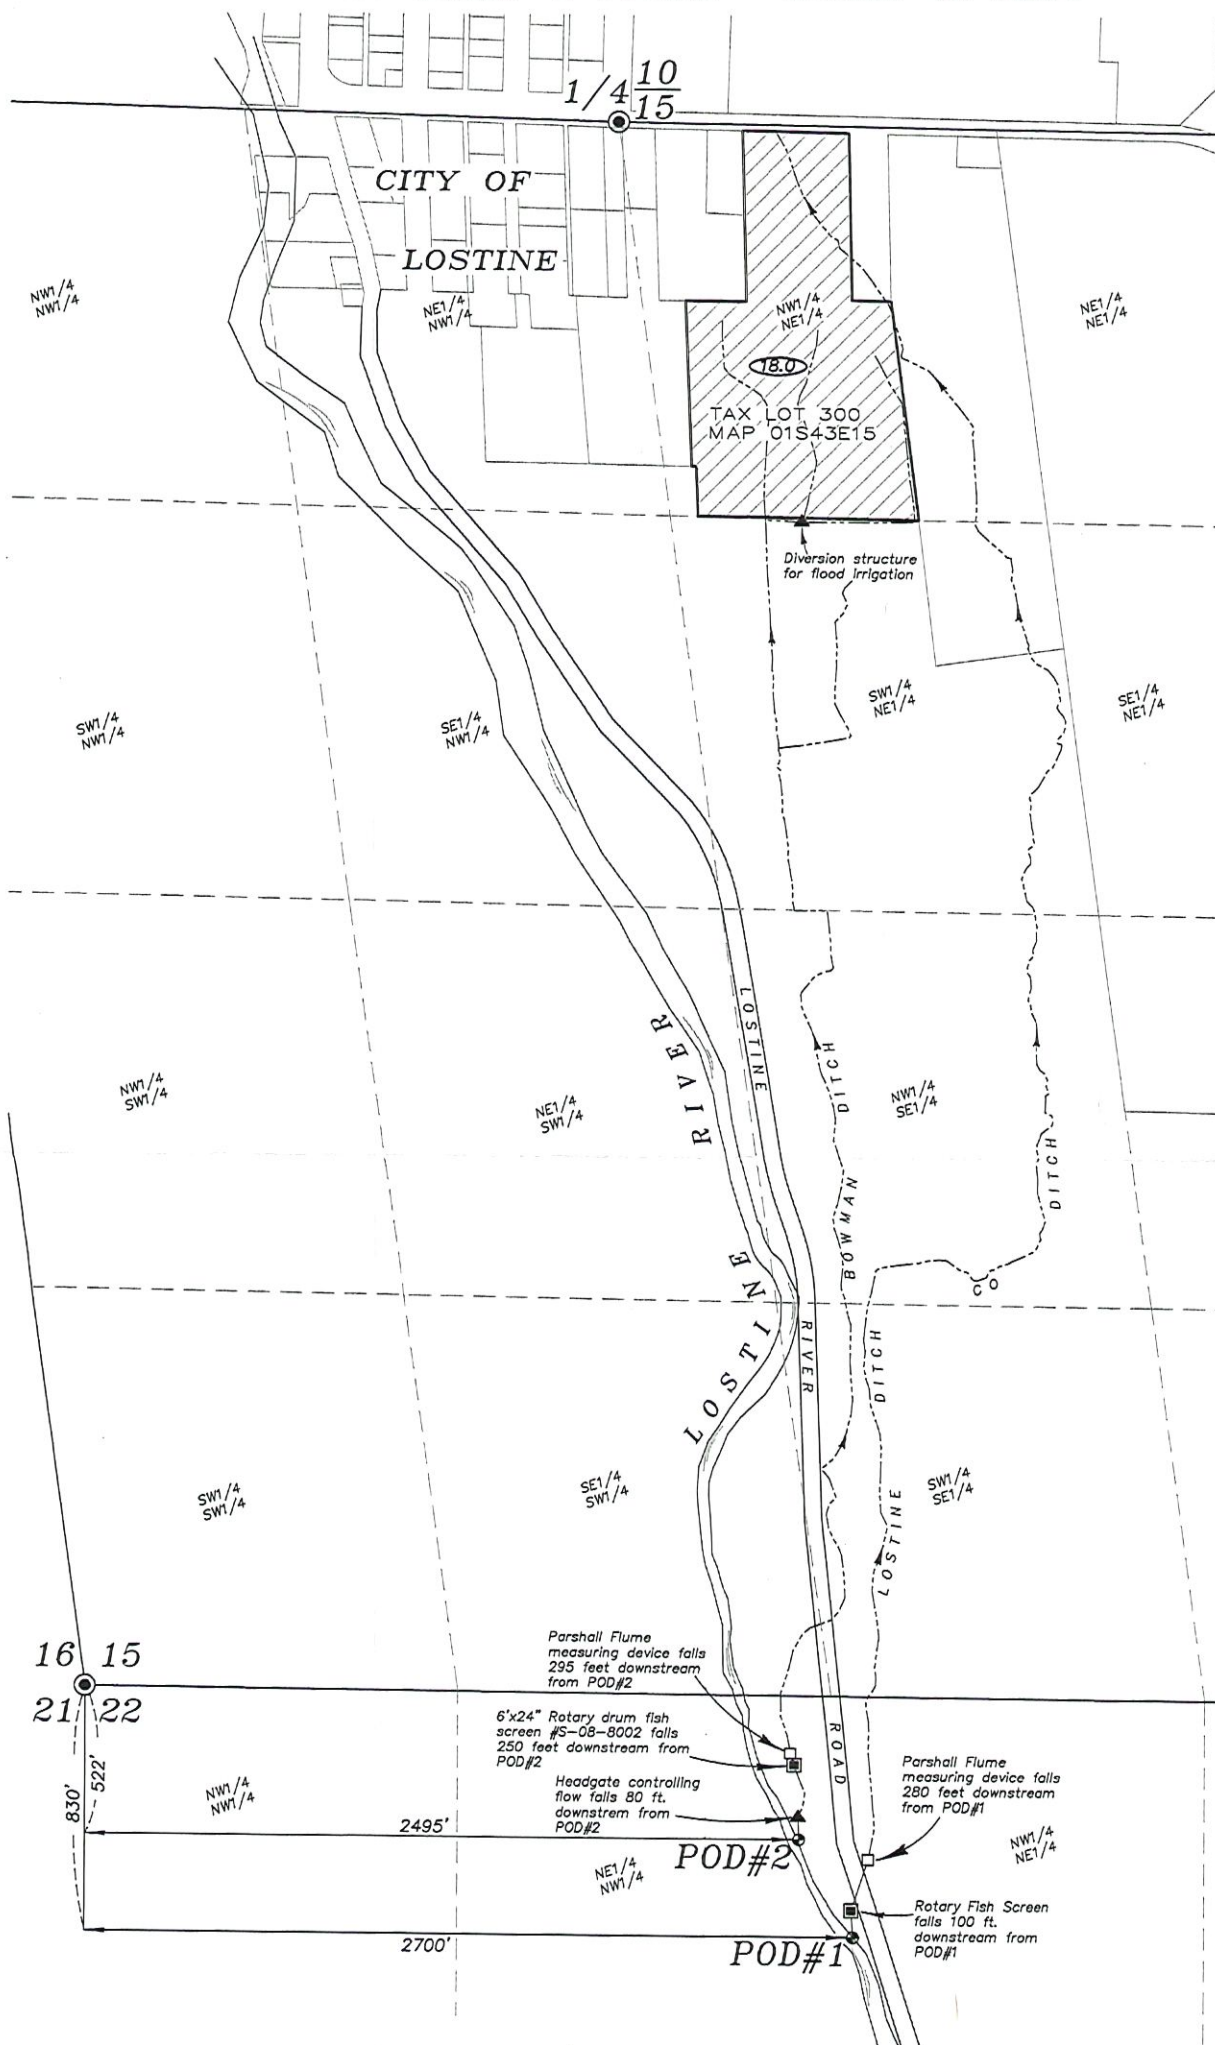

LEGEND

- Survey Monument
- Point of Diversion
- ▲ Headgate
- Fish Bypass
- Parshall Flume



SCALE: 1"=400'

October 5,, 2023
CLAIM OF BENEFICIAL USE
FOR AN ADDITIONAL POINT OF
DIVERSION
FOR
CATHY JOHNSON

BY
BAGETT - GRIFFITH & BLACKMAN
2006 ADAMS AVENUE
LAGRANDE, OREGON 97850

RECEIVED
NOV 18 2023

APPLICATION NO. T-12603

OWRD

PERMIT NO.



Renews: June 30, 2025

NOTE: The preparation of this map was for the purpose of identifying the location of water rights and has no intent to provide dimensions or location of property ownership lines. Location information shown hereon was furnished by the applicant.