

SECTION

sect 30


1" = 1320'

Tax Lot 701

TOWNSHIP 3^{South}, RANGE 1^{West}, W. M.

↑ North

North

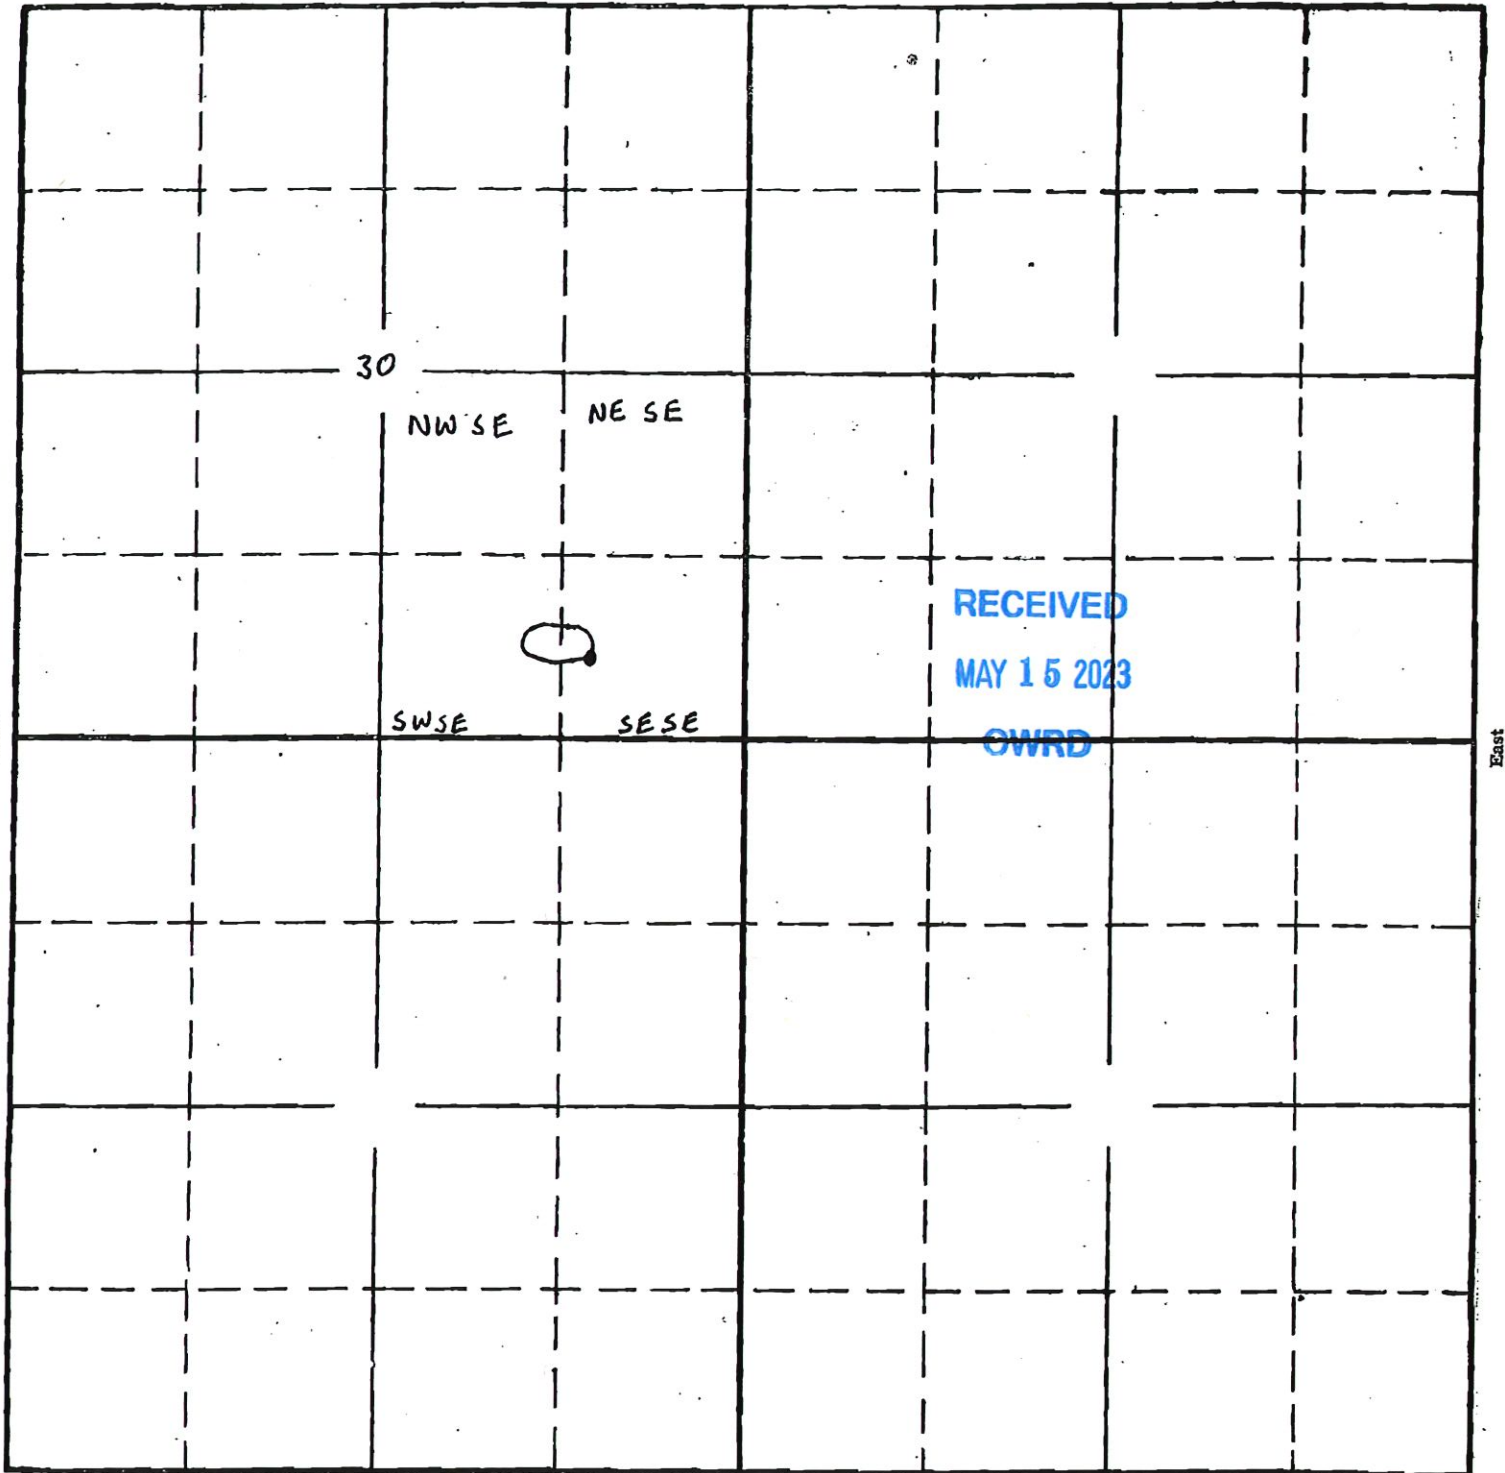

South

Dam Loc 675 feet North and 1200 feet
West from SE Corner Section 30

APPLICATION No.

PERMIT No.

R-8700

[Signature]
2/15/12