


Claim of Beneficial Use - Brown

Application S-89236, Permit S-55461

Township 11S, Range 1 E, Section 18, W.M.

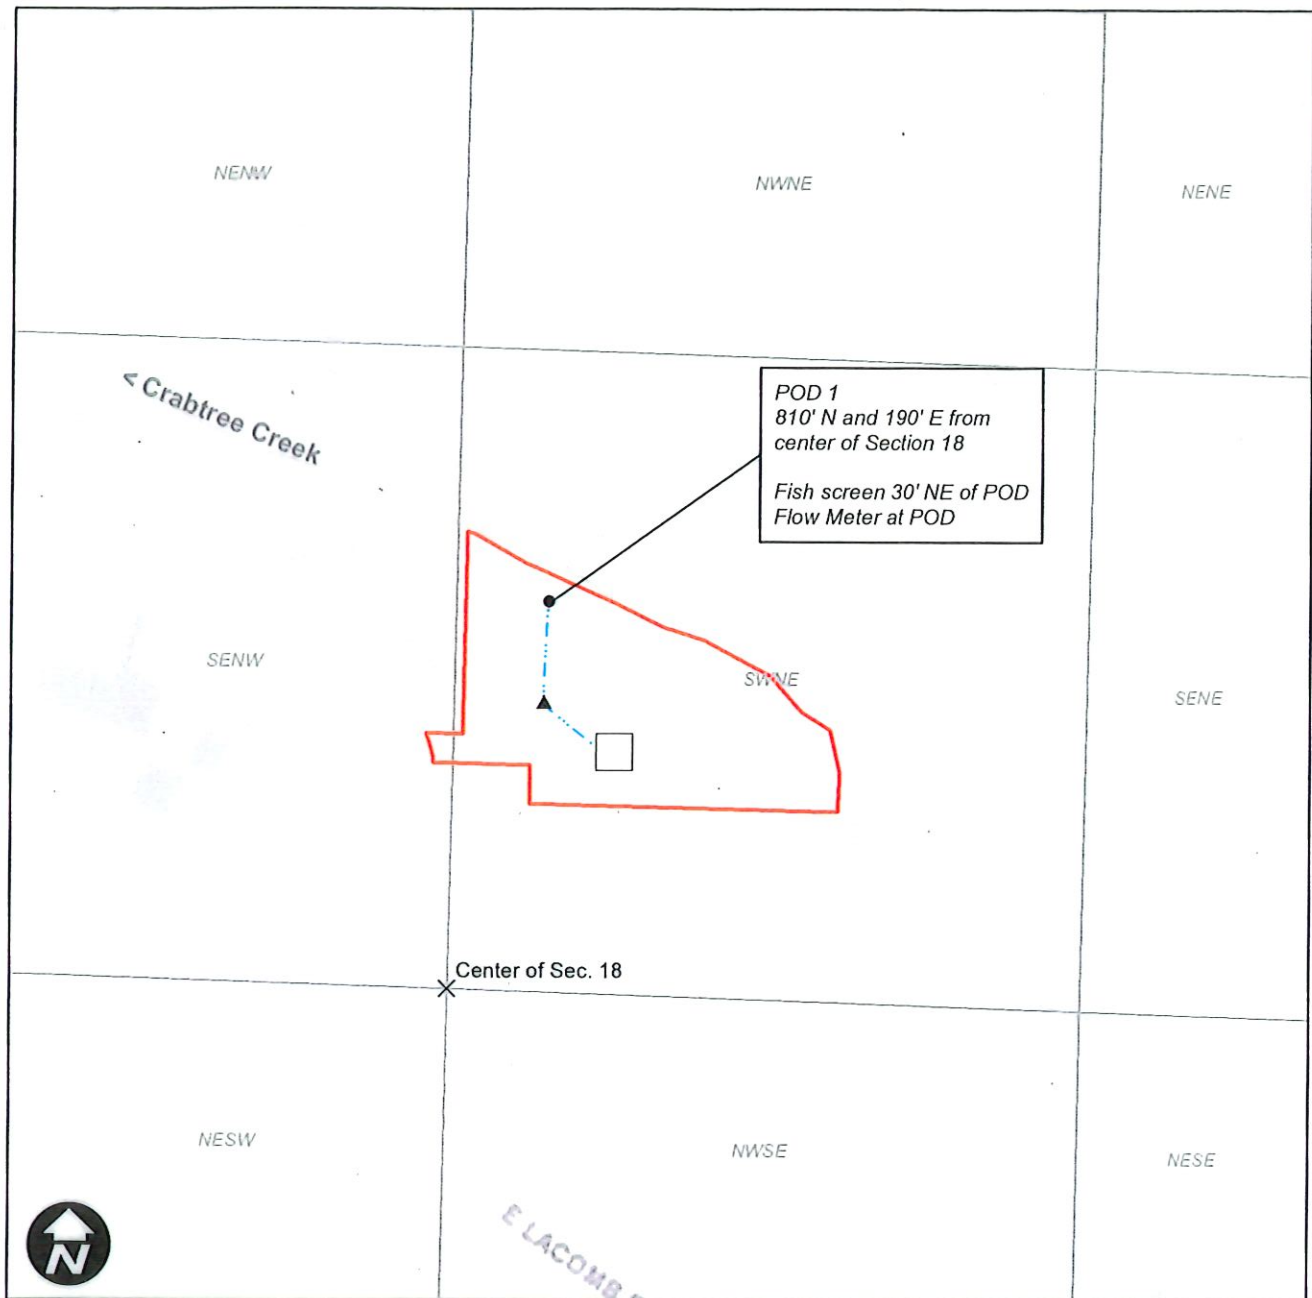

0 200 400 800 Feet

This map is not intended to provide legal dimensions or locations of property ownership lines.

Legend

- ▲ Storage Tank
- Pipeline
- House
- Tax Lot 200



Received by OWRD

NOV 18 2024

Salem, OR

EXPIRES: 12-31-2024