


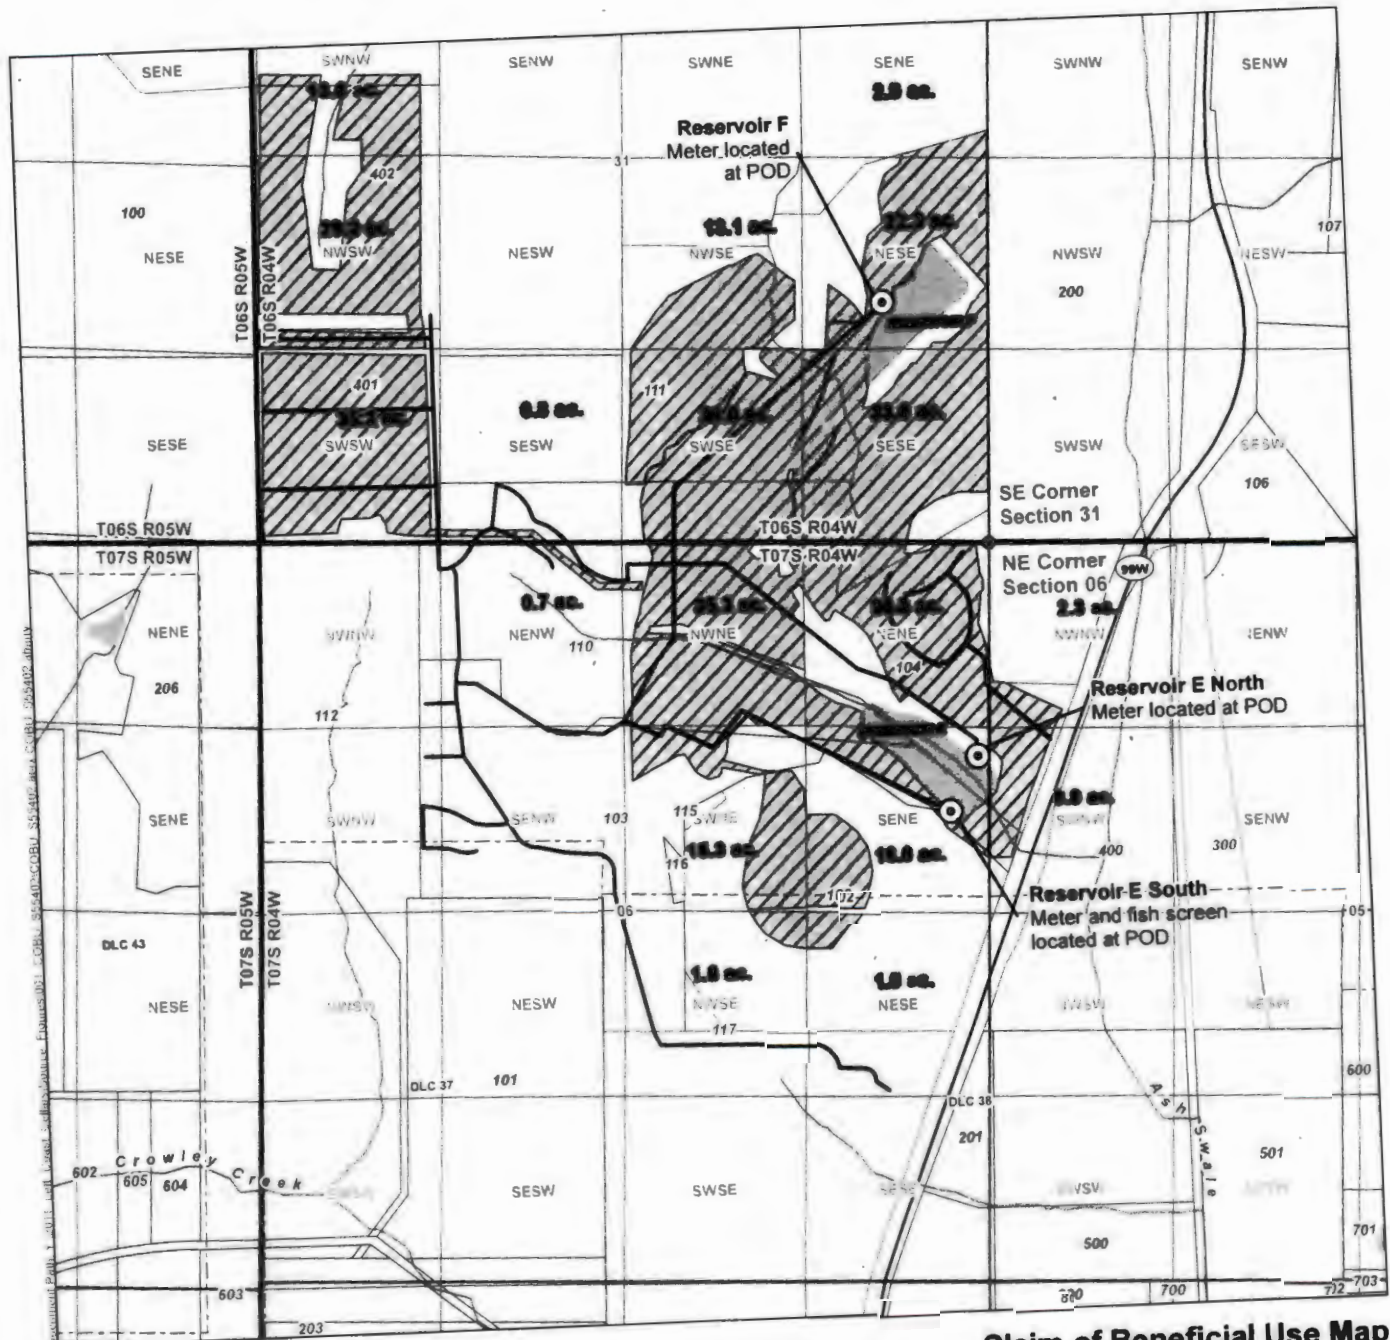

LEGEND

- Point of Diversion (POD)
- Conveyance
- Place of Use (POU)
- Donation Land Claim (DLC)
- Tax Lot
- Watercourse
- Waterbody

Claim of Beneficial Use Map Left Coast Cellars, LLC


Application S-72659, Permit S-55402

Polk County
Township 6, 7 South, Range 4 West (W.M.)

RECEIVED
JAN 10 2023

OWRD RECEIVED
MAR 20 2023

CERTIFIED WATER RIGHTS EXAMINER STAMP

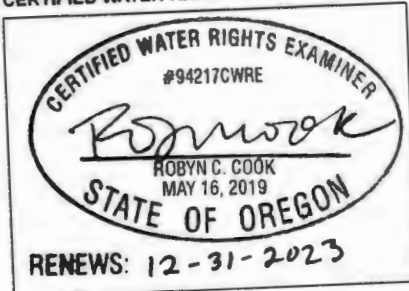

LOCATION DESCRIPTION

Reservoir E North
Located 1530 feet South and 55 West from the NE corner of Section 6, Township 7 South, Range 4 West (W.M.).
Coordinates: Latitude: 44.994908, Longitude: -123.214909

Reservoir E South
Located 1920 feet South and 255 West from the NE corner of Section 6, Township 7 South, Range 4 West (W.M.).
Coordinates: Latitude: 44.993823, Longitude: -123.215686

Reservoir F
Located 1680 feet North and 765 South from the SE corner of Section 31, Township 6 South, Range 4 West (W.M.).
Coordinates: Latitude: 45.00383, Longitude: -123.217487

DISCLAIMER

This map was prepared for the purpose of identifying the location of a water right only and it is not intended to provide legal dimensions or location of property ownership lines.

Date: October 20, 2022

Data Sources: BLM, ESRI, OWRD, USGS, Polk County

