
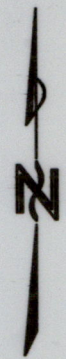


T9S, R28E, W.M.
GRANT COUNTY, OREGON

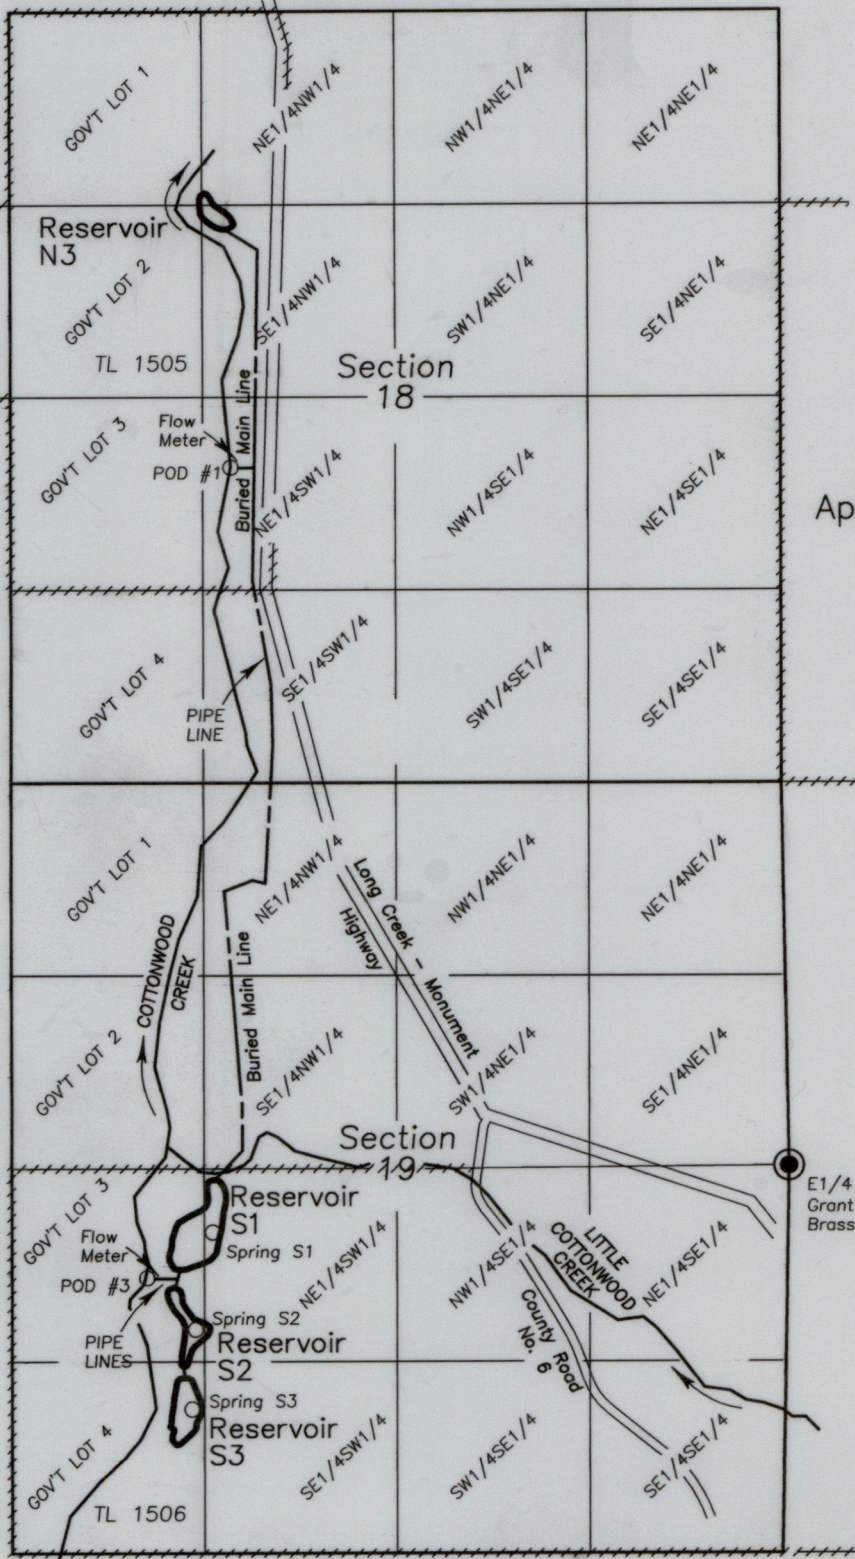

Scale 1"=1320'
Surveyed March 18, 2023

CLAIM OF BENEFICIAL USE

Application R-88319 Permit R-15323

For
TRIPLE 7 RANCH, LLC
March 24, 2023

A portion of Tax Lots
9-28 TL 1505 & 1506

LEGEND


++++++ Tax Lot Boundary

RECEIVED

APR 10 2023

OWRD

E1/4 Corner Sec 19
Grant County Surveyor
Brass Cap

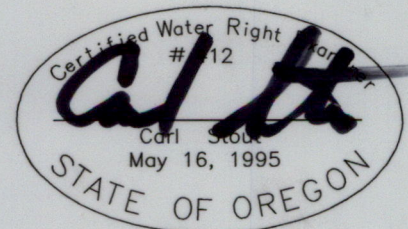

POD #1 is 4810' north and 3820' west of the E1/4 corner of Section 19.
A flow meter is located 12 ft. east of POD #1.
POD #3 is 760' south and 4410' west of the E1/4 corner of Section 19.
A flow meter is located 10 ft. east of POD #3.
Spring S1 is 450' south and 3950' west of the E1/4 corner of Section 19.
Spring S2 is 1120' south and 4070' west of the E1/4 corner of Section 19.
Spring S3 is 1660' south and 4090' west of the E1/4 corner of Section 19.

NOTE: The preparation of this map was for the purpose of identifying the location of the proposed water right and has no intent to provide dimensions or location of property ownership lines.