



CLAIM OF BENEFICIAL USE MAP
APPLICATION S-88654 PERMIT S-55255
TOWNSHIP 28 S. RANGE 14 W. SECTION 16 W.M.

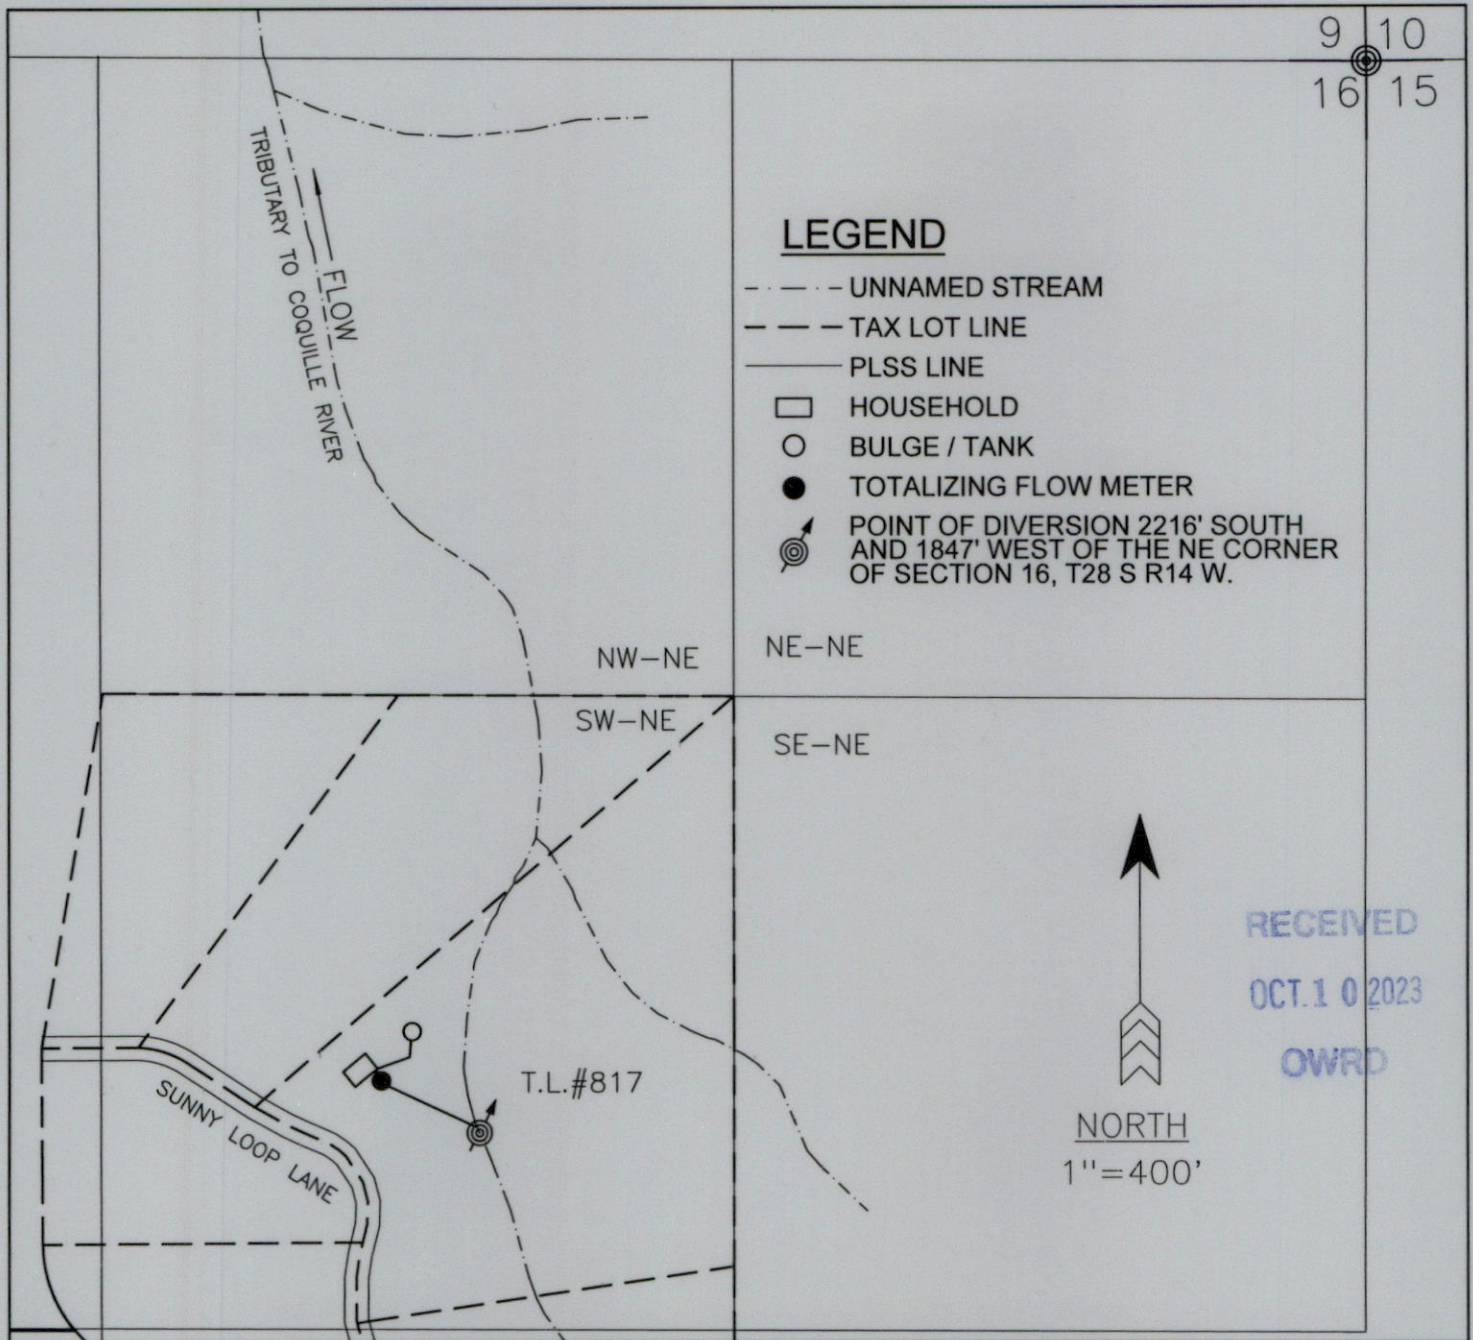

DISCLAIMER: THIS MAP WAS PREPARED FOR THE PURPOSE OF IDENTIFYING THE LOCATION OF WATER RIGHT ONLY AND IS NOT INTENDED TO PROVIDE LEGAL DESCRIPTIONS OR LOCATIONS OF PROPERTY LINES.

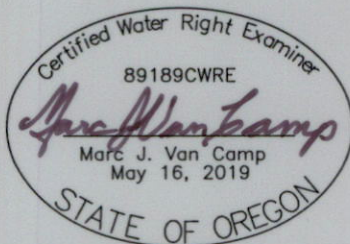

EXPIRES 06/30/2024

VCC

**VAN CAMP
CONSULTING**

P.O. Box 995
Coos Bay, OR 97420
(541) 297-1880
vancampconsulting@gmail.com

Prepared For:
Thomas Zephyrs &
Lucille Perkins
89308 Sunny Loop Ln
Bandon, OR 97411

Project:
Permit S-55255
Claim of Beneficial
Use

Date:
August 4, 2023