


# T25S R31E, WM, HARNEY COUNTY, OR

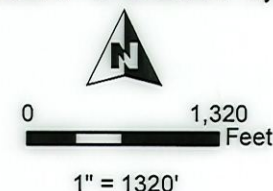


- Well & Meter
- Pipeline
- POU IR (from G-6961) 8-12-1976 Priority
- POU IR (from G-9879) 4-19-1982 Priority
- Section
- Quarter Quarter
- Tax Lot


RECEIVED

MAR 04 2021

OWRD

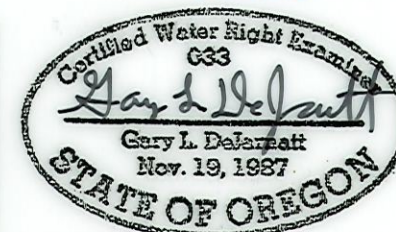

RENEWAL DATE 12/31/2021

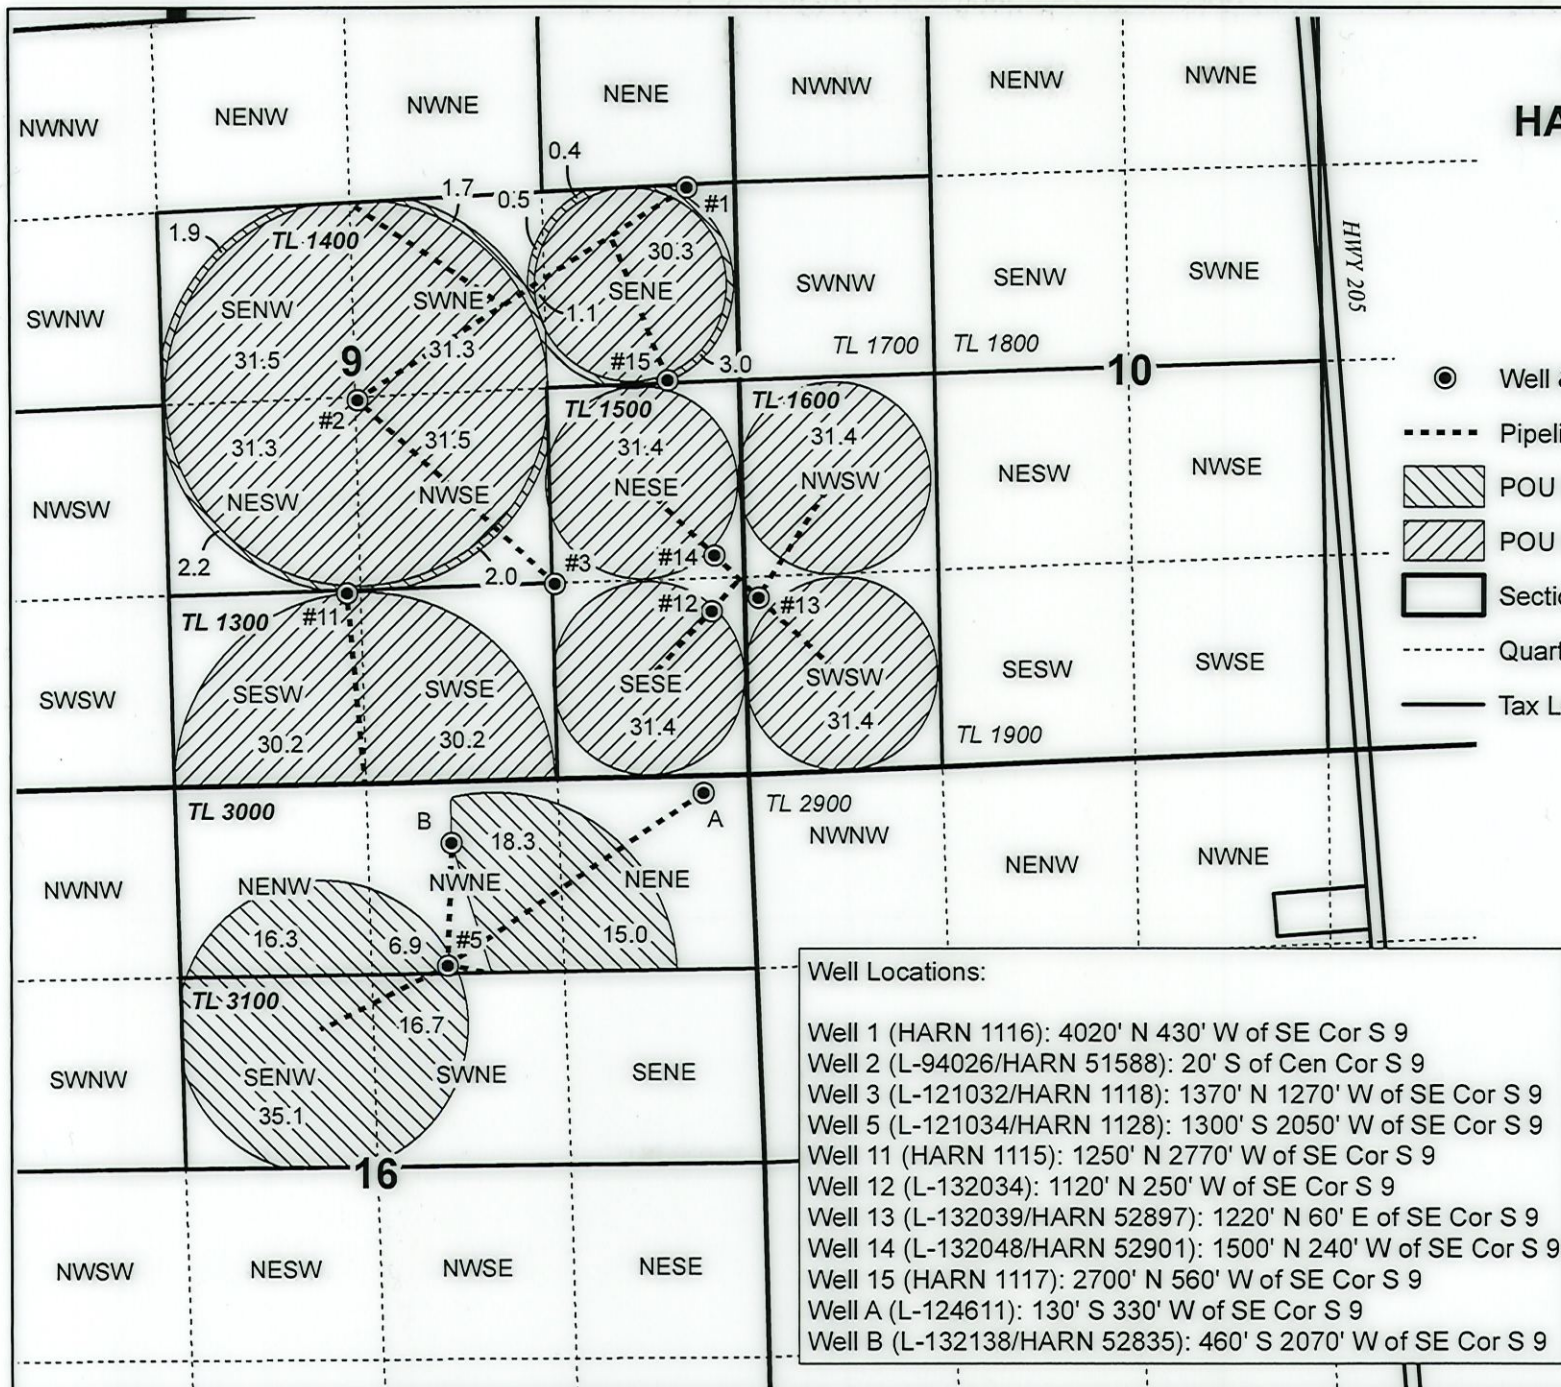

## Well Locations:

- Well 1 (HARN 1116): 4020' N 430' W of SE Cor S 9
- Well 2 (L-94026/HARN 51588): 20' S of Cen Cor S 9
- Well 3 (L-121032/HARN 1118): 1370' N 1270' W of SE Cor S 9
- Well 5 (L-121034/HARN 1128): 1300' S 2050' W of SE Cor S 9
- Well 11 (HARN 1115): 1250' N 2770' W of SE Cor S 9
- Well 12 (L-132034): 1120' N 250' W of SE Cor S 9
- Well 13 (L-132039/HARN 52897): 1220' N 60' E of SE Cor S 9
- Well 14 (L-132048/HARN 52901): 1500' N 240' W of SE Cor S 9
- Well 15 (HARN 1117): 2700' N 560' W of SE Cor S 9
- Well A (L-124611): 130' S 330' W of SE Cor S 9
- Well B (L-132138/HARN 52835): 460' S 2070' W of SE Cor S 9

## CLAIM OF BENEFICIAL USE MAP TRAVIS & KELLY SINGHOSE

T-12819

Date: 2/10/2021

Project #20080

This map is not intended  
to provide legal dimensions  
or locations of property  
ownership lines.

**WATER RIGHT SERVICES, LLC**  
PO BOX 1830, BEND, OR 97709  
[WWW.OREGONWATER.US](http://WWW.OREGONWATER.US) CCB # 197121  
[johnshort@usa.com](mailto:johnshort@usa.com) 541-389-2837