


T.7S. R.1W. Sec. 7 and 18, W.M.

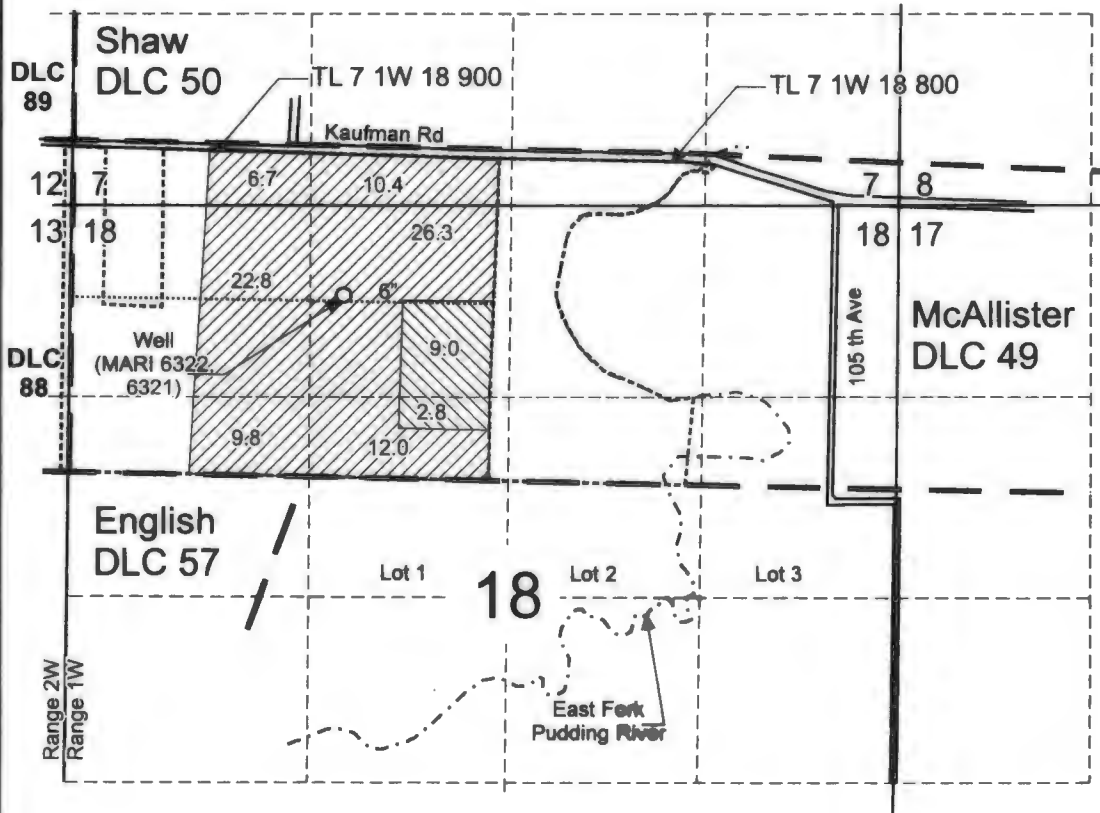

RECEIVED
FEB 24 2023
OWRD

Well (MARI 6322, 6321) is located 610 feet south and 1,850 feet east from the NW corner, Section 18.

 Area (88.0 Acres) of primary irrigation under T-13349, formerly Certificate 51890, priority date: January 30, 1975.

 Area (11.8 Acres) of supplemental irrigation under T-13349, formerly Certificate 51890, priority date: January 30, 1975. Primary use under former Certificate 48895.

----- Tax lot boundary

— Donation Land Claim boundary

..... Irrigation mainlines



Scale: 1" = 1,320'



This map was prepared for the purpose of identifying the location of a water right only and is not intended to provide legal dimensions or location of property ownership lines.

Claim of Beneficial Use Map
T-13349, formerly Certificate 51890

Pacific Hydro-Geology Inc.

Troy and Sherri Kuenzi
T.7S. R.1W. Sec. 7 and 18, W.M.

08/2022