


T.7S. R.1W. Sec. 7 and 18, W.M.

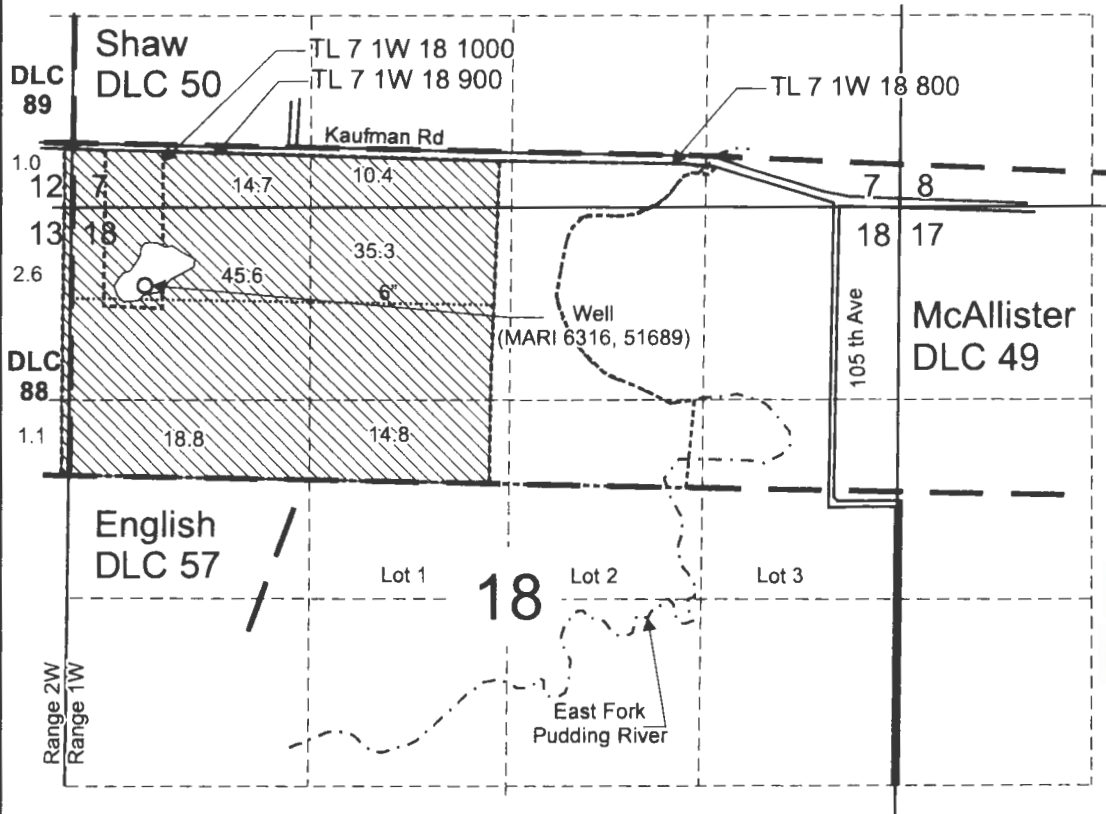

RECEIVED
FEB 24 2012
OWRD

Well (MARI 6316, 51689) is located 530 feet south and 490 feet east from the NW corner, Section 18.

 Area (144.3 Acres) of supplemental irrigation under T-13349, formerly Certificate 92060, priority date, October 16, 1990.

- Tax lot boundary
- Donation Land Claim boundary
- Irrigation mainlines



Scale: 1' = 1,320'



This map was prepared for the purpose of identifying the location of a water right only and is not intended to provide legal dimensions or location of property ownership lines.

Claim of Beneficial Use Map
T-13349, formerly Certificate 92060

Pacific Hydro-Geology Inc.

08/2022

Troy and Sherri Kuenzi
T.7S. R.1W. Sec. 7 and 18, W.M.