
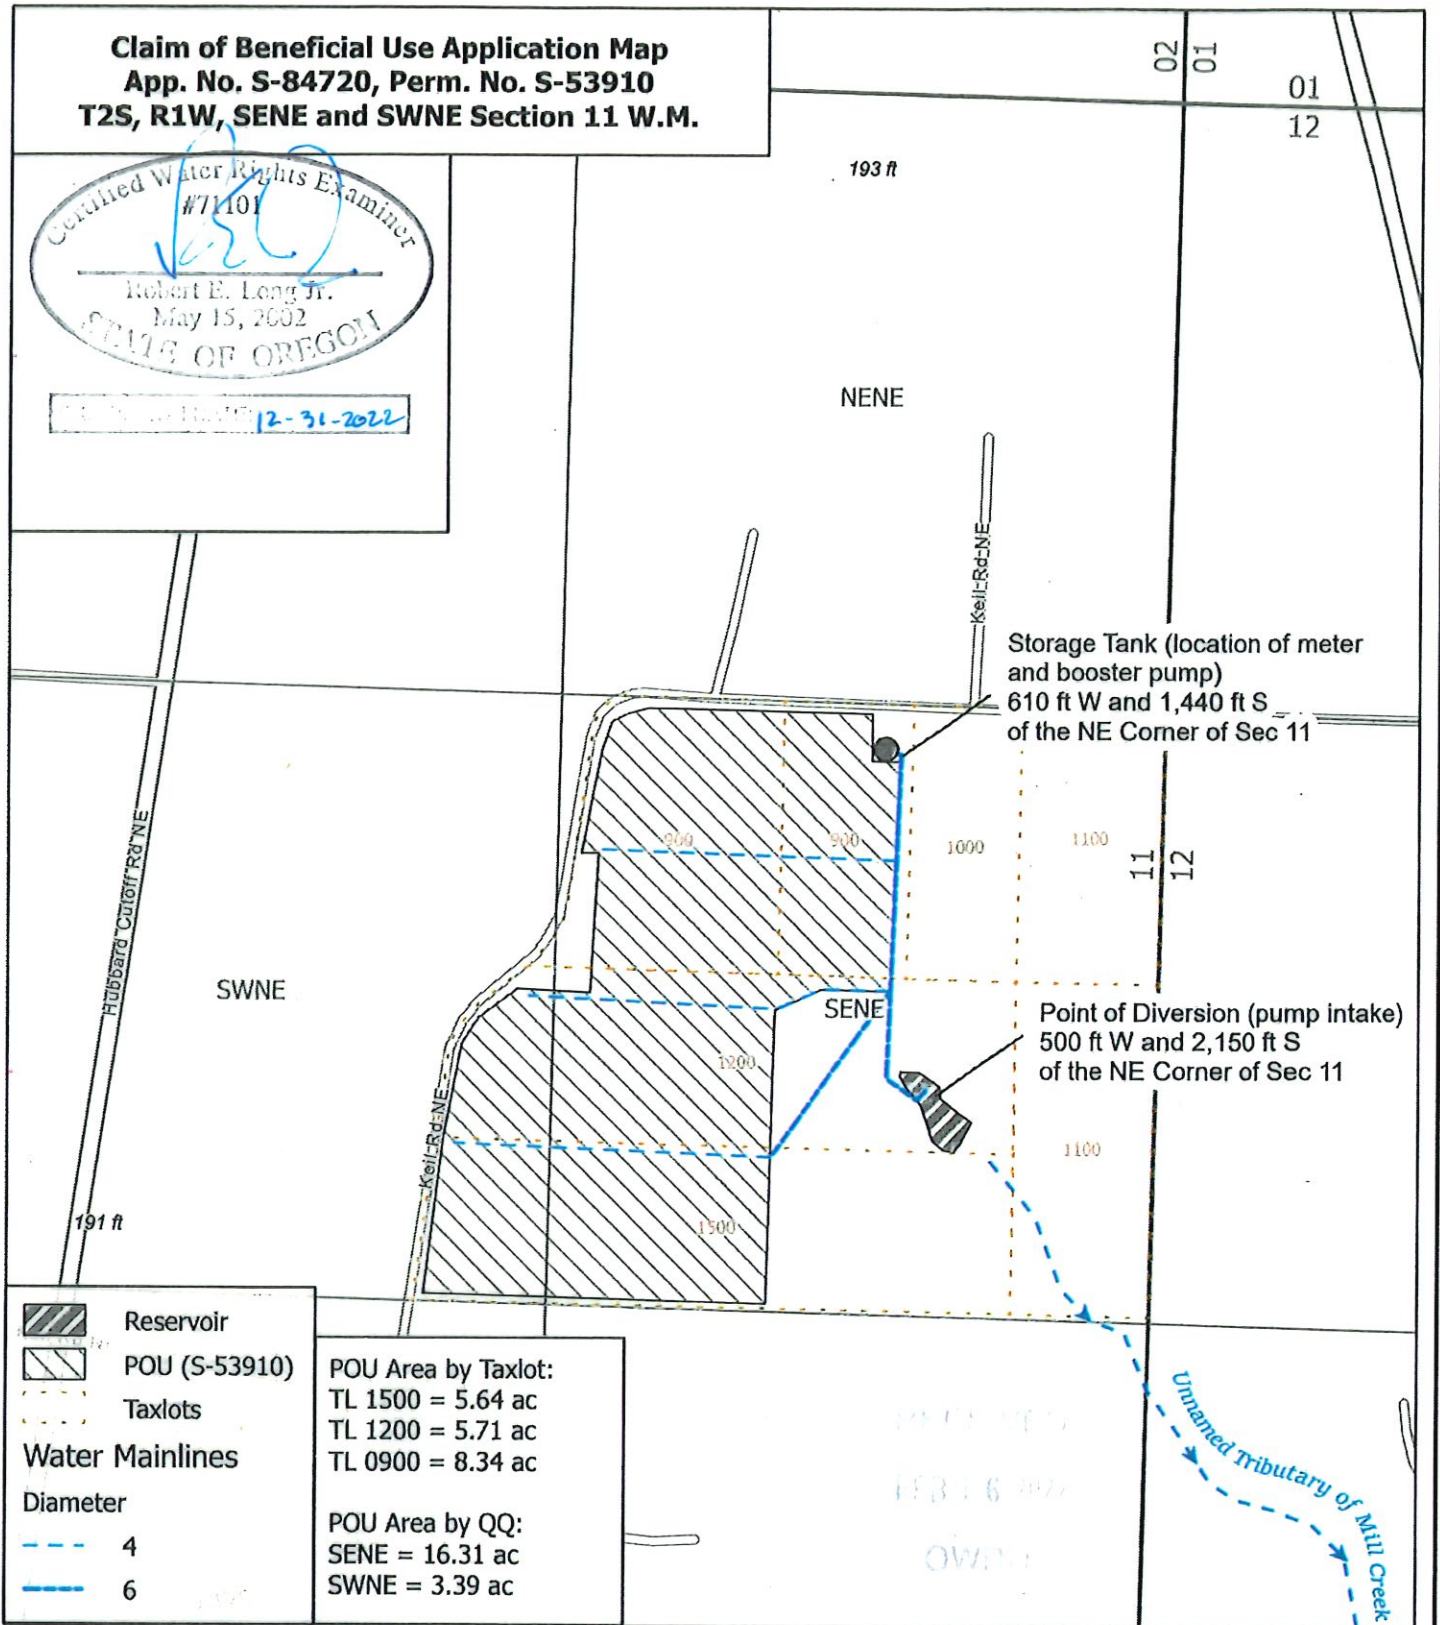


Claim of Beneficial Use Application Map
App. No. S-84720, Perm. No. S-53910
T2S, R1W, SENE and SWNE Section 11 W.M.

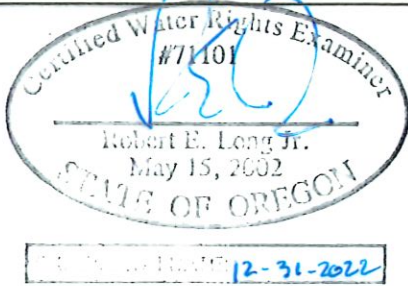

- Reservoir
- POU (S-53910)
- Taxlots
- Water Mainlines**
- Diameter**
- 4
- 6

POU Area by Taxlot:
 TL 1500 = 5.64 ac
 TL 1200 = 5.71 ac
 TL 0900 = 8.34 ac


POU Area by QQ:
 SENE = 16.31 ac
 SWNE = 3.39 ac

CwM-H2O
 Complete Water Management

1319 SE MLK, Jr. Blvd, Suite 204
 Portland, Oregon 97214
 (503) 954-1326

This map is not intended to provide
 legal dimensions or locations of
 property ownership lines.

1	DATE	AUTH	DRAFT
No.	Date	By	Revisions

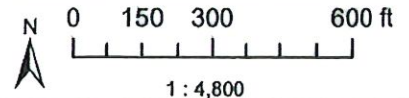

Proj#: 2123001
Oregon Flowers CBU's
 Oregon Flowers
 20727 Highway 99E NE
 Aurora, OR, 97002