
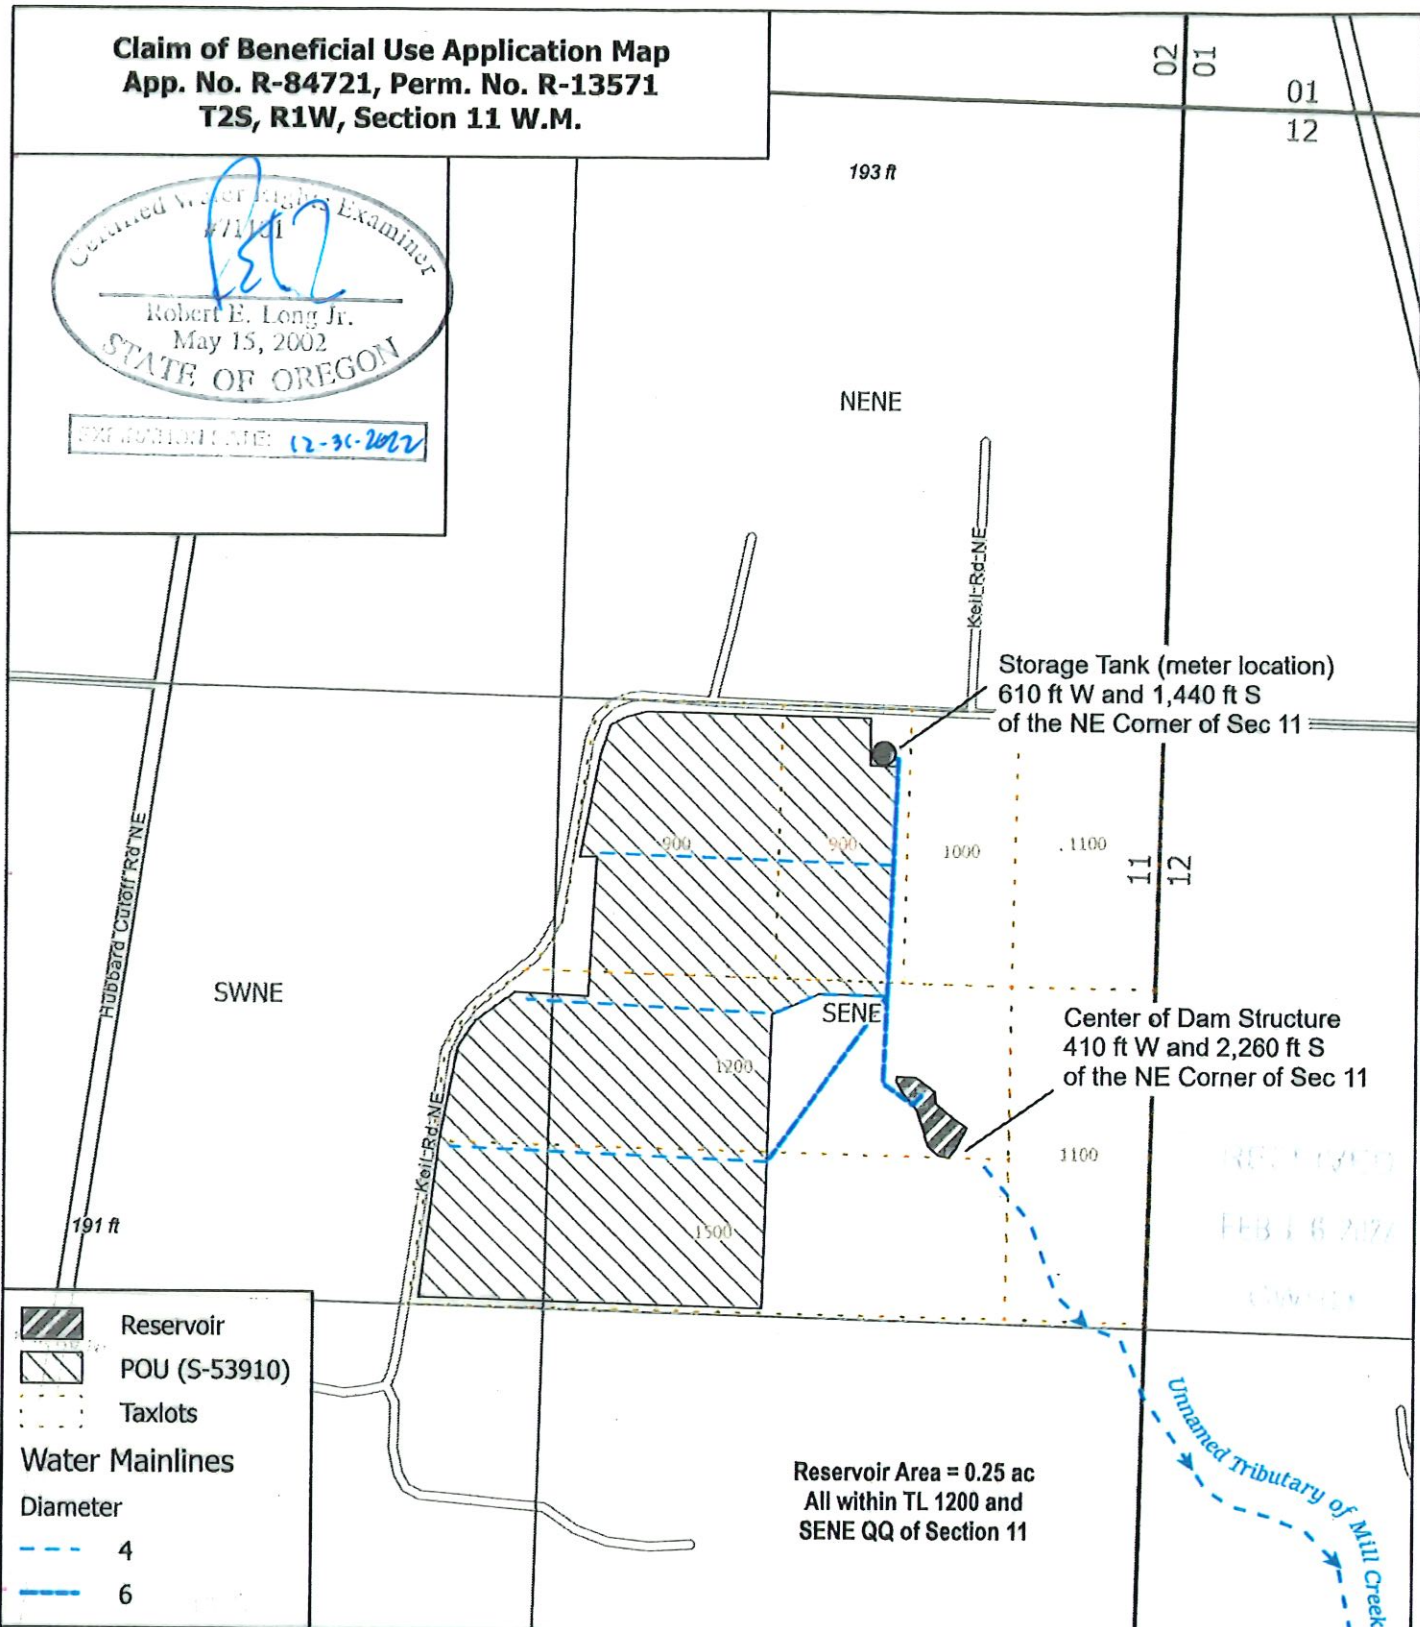


Claim of Beneficial Use Application Map
App. No. R-84721, Perm. No. R-13571
T2S, R1W, Section 11 W.M.

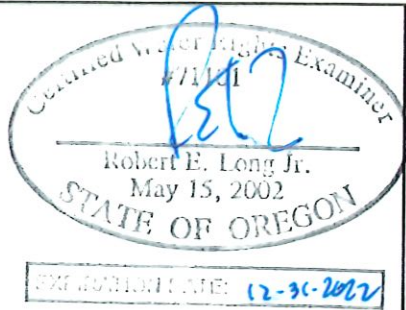

- Reservoir
- POU (S-53910)
- Taxlots
- Water Mainlines**
- Diameter**
- 4
- 6


Reservoir Area = 0.25 ac
 All within TL 1200 and
 SENE QQ of Section 11

CwM-H2O
 Complete Water Management

1319 SE MLK, Jr. Blvd, Suite 204
 Portland, Oregon 97214
 (503) 954-1326

This map is not intended to provide
 legal dimensions or locations of
 property ownership lines.

1	DATE	AUTH	DRAFT
No.	Date	By	Revisions

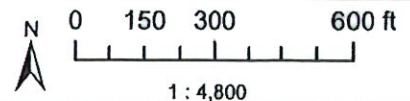

Proj#: 2123001
Oregon Flowers CBU's
 Oregon Flowers
 20727 Highway 99E NE
 Aurora, OR, 97002