

STATE OF OREGON

COUNTY OF DOUGLAS

CERTIFICATE OF WATER RIGHT

THIS CERTIFICATE ISSUED TO

GREGORY TIMM
1224 NW RIVERFRONT DR
ROSEBURG OR 97471

confirms the right to the use of water perfected under the terms of Right S-55229. The amount of water used to which this right is entitled is limited to the amount used beneficially, and shall not exceed the amount specified, or its equivalent in the case of rotation, measured at the point of diversion from the source. The specific limits and conditions of the use are listed below.

APPLICATION FILE NUMBER: S-88769

SOURCE OF WATER: GALESVILLE RESERVOIR, CONSTRUCTED UNDER RIGHT R-9964, TRIBUTARY OF UMPQUA RIVER

PURPOSE or USE: IRRIGATION OF 0.6 ACRES

MAXIMUM RATE: 1.34 ACRE-FEET (OR AS FURTHER LIMITED BY CONTRACT)

PERIOD OF USE: MARCH 1 THROUGH OCTOBER 31

DATE OF PRIORITY: MAY 2, 2019

The point of diversion is located as follows:

Twp	Rng	Mer	Sec	Q-Q	Measured Distances
27 S	6 W	WM	14	NE SW	430 FEET SOUTH AND 840 FEET WEST FROM C1/4 CORNER, SECTION 14

The amount of water used for irrigation, together with the amount secured under any other right existing for the same lands, shall be limited to a diversion of not to exceed 2.23 acre-feet per acre for each acre irrigated during the irrigation season of each year.

A description of the place of use is as follows:

Twp	Rng	Mer	Sec	Q-Q	Acres
27 S	6 W	WM	14	NE SW	0.60

NOTICE OF RIGHT TO PETITION FOR RECONSIDERATION OR JUDICIAL REVIEW

This is an order in other than a contested case. This order is subject to judicial review under ORS 183.484 and ORS 536.075. Any petition for judicial review must be filed within the 60-day time period specified by ORS 183.484(2). Pursuant to ORS 183.484, ORS 536.075 and OAR 137-004-0080, you may petition for judicial review and petition the Director for reconsideration of this order. A petition for reconsideration may be granted or denied by the Director, and if no action is taken within 60 days following the date the petition was filed, the petition shall be deemed denied. In addition, under ORS 537.260 any person with an application, right or water right certificate subsequent in priority may jointly or severally contest the issuance of the certificate within three months after issuance of the certificate.

Water Use Measurement, Recording, and Reporting Condition:

- A. The water user shall maintain the device in good working order at each point of diversion.
- B. The water user shall allow the watermaster access to the device; provided however, where any device is located within a private structure, the watermaster shall request access upon reasonable notice.
- C. The Director may require the water user to keep and maintain a record of the volume of water diverted, and may require the water user to report water-use on a periodic schedule as established by the Director. In addition, the Director may require the water user to report general water-use information, the periods of water use and the place and nature of use of water under the right.
- D. The Director may provide an opportunity for the water user to submit alternative measuring and reporting procedures for review and approval.

The water user shall maintain and operate fish screening consistent with current Oregon Department of Fish and Wildlife (ODFW) standards. Fish screening is to prevent fish from entering the diversion.

The use of water under this right is subject to the terms and conditions of contract No. I-2019-4, or a satisfactory replacement, between Douglas County and the water user, a copy of which must be on file in the records of the Water Resources Department.

Failure to comply with any of the provisions of this right may result in action including, but not limited to, restrictions on the use, civil penalties, or cancellation of the right.

Where two or more water users agree among themselves as to the manner of rotation in the use of water and such agreement is placed in writing and filed by such water users with the watermaster, and such rotation system does not infringe upon such prior rights of any water user not a party to such rotation plan, the watermaster shall distribute the water according to such agreement.

This right is for the beneficial use of water without waste. The water user is advised that new regulations may require the use of best practical technologies or conservation practices to achieve this end.

By law, the land use associated with this water use must be in compliance with statewide land use goals and any local acknowledged land use plan.

The use of water allowed herein may be made only at times when sufficient water is available to satisfy all prior rights, including prior rights for maintaining instream flows.

The right to the use of the water for the above purpose is restricted to beneficial use on the place of use described.

Issued _____.

Katherine Ratcliffe
Water Right Services Division Administrator, for
Ivan Gall, Director
Oregon Water Resources Department


CLAIM of BENEFICIAL USE MAP

FOR: GREGORY TIMM
BY: NATHAN REED, PE, CWRE
T27S, R6W, W.M. SECTION 14
APPLICATION NO. S-88769
PERMIT NO. S-55229




SCALE: 1" = 400'

DATE OF SURVEY: SEPTEMBER 13, 2024

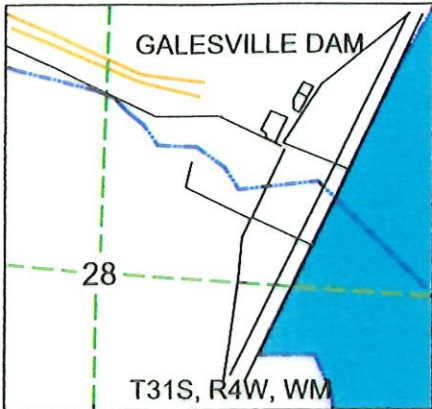


SCALE: 1" = 400'

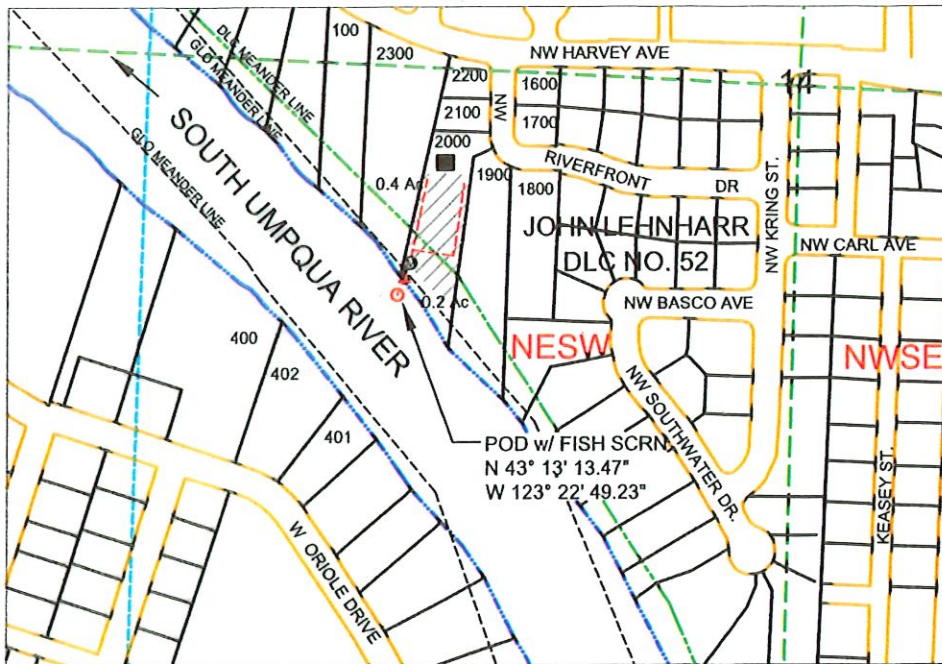

Received
DEC 02 2024
OWRD

POD IS LOCATED 430 FEET SOUTH & 840 FEET WEST OF C1/4 CORNER OF SECTION 14.

Received
OCT 18 2024
OWRD

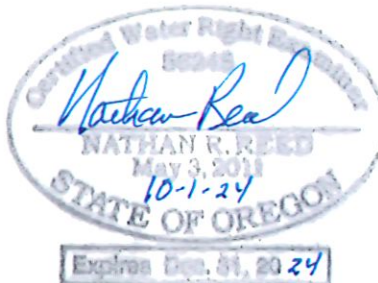

LEGEND

	WATER POD PUMP METER		QUARTER SIXTEENTH DLC
	PIPE		GLOT
	MEANDER		PARCEL
			IRRIGATION

MAP PREPARED FOR:
GREGORY TIMM
1224 NW RIVERFRONT DR.
ROSEBURG, OR 97471

MAP PREPARED BY:
NATHAN REED PE, CWRE
157 WEST BODIE STREET
ROSEBURG, OR 97471

THE PURPOSE OF THIS MAP IS TO IDENTIFY THE LOCATION OF THE WATER RIGHT. IT IS NOT INTENDED TO PROVIDE INFORMATION RELATIVE TO THE LOCATION OF PROPERTY OWNERSHIP BOUNDARY LINES.