

APPLICATION G-12852 PERMIT G-13464

WELL LOCATION:

252' NORTH & 3053' WEST
OF THE SOUTHEAST CORNER
SECTION 11.
FLOW METER LOCATED AT WELL.


FINAL PROOF SURVEY

FOR
RONALD KING & MARCI LYNN KING
30836 CROSSROADS LANE
EUGENE, OREGON 97408

BY
H. TIMOTHY FASSBENDER, PLS,OWRE
2896 SARAH LANE
EUGENE, OREGON 97408
September 28, 2018

NOTE

THIS MAP WAS PREPARED FOR THE PURPOSE
OF IDENTIFYING THE LOCATION OF THE WATER
RIGHT ONLY. IT IS NOT INTENDED TO PROVIDE
DIMENSIONS OR LOCATION OF PROPERTY
OWNERSHIP LINES.

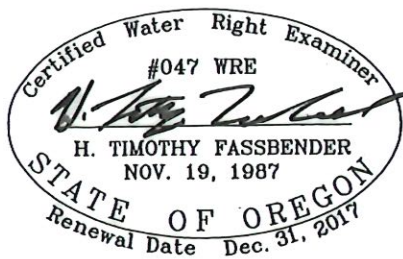

RECEIVED

NOV 07 2018

OWRD