


Claim of Beneficial Use - Green Gold Ag, LLC

Application S-88692, Permit S-55216

Township 11S, Range 4W, W.M.

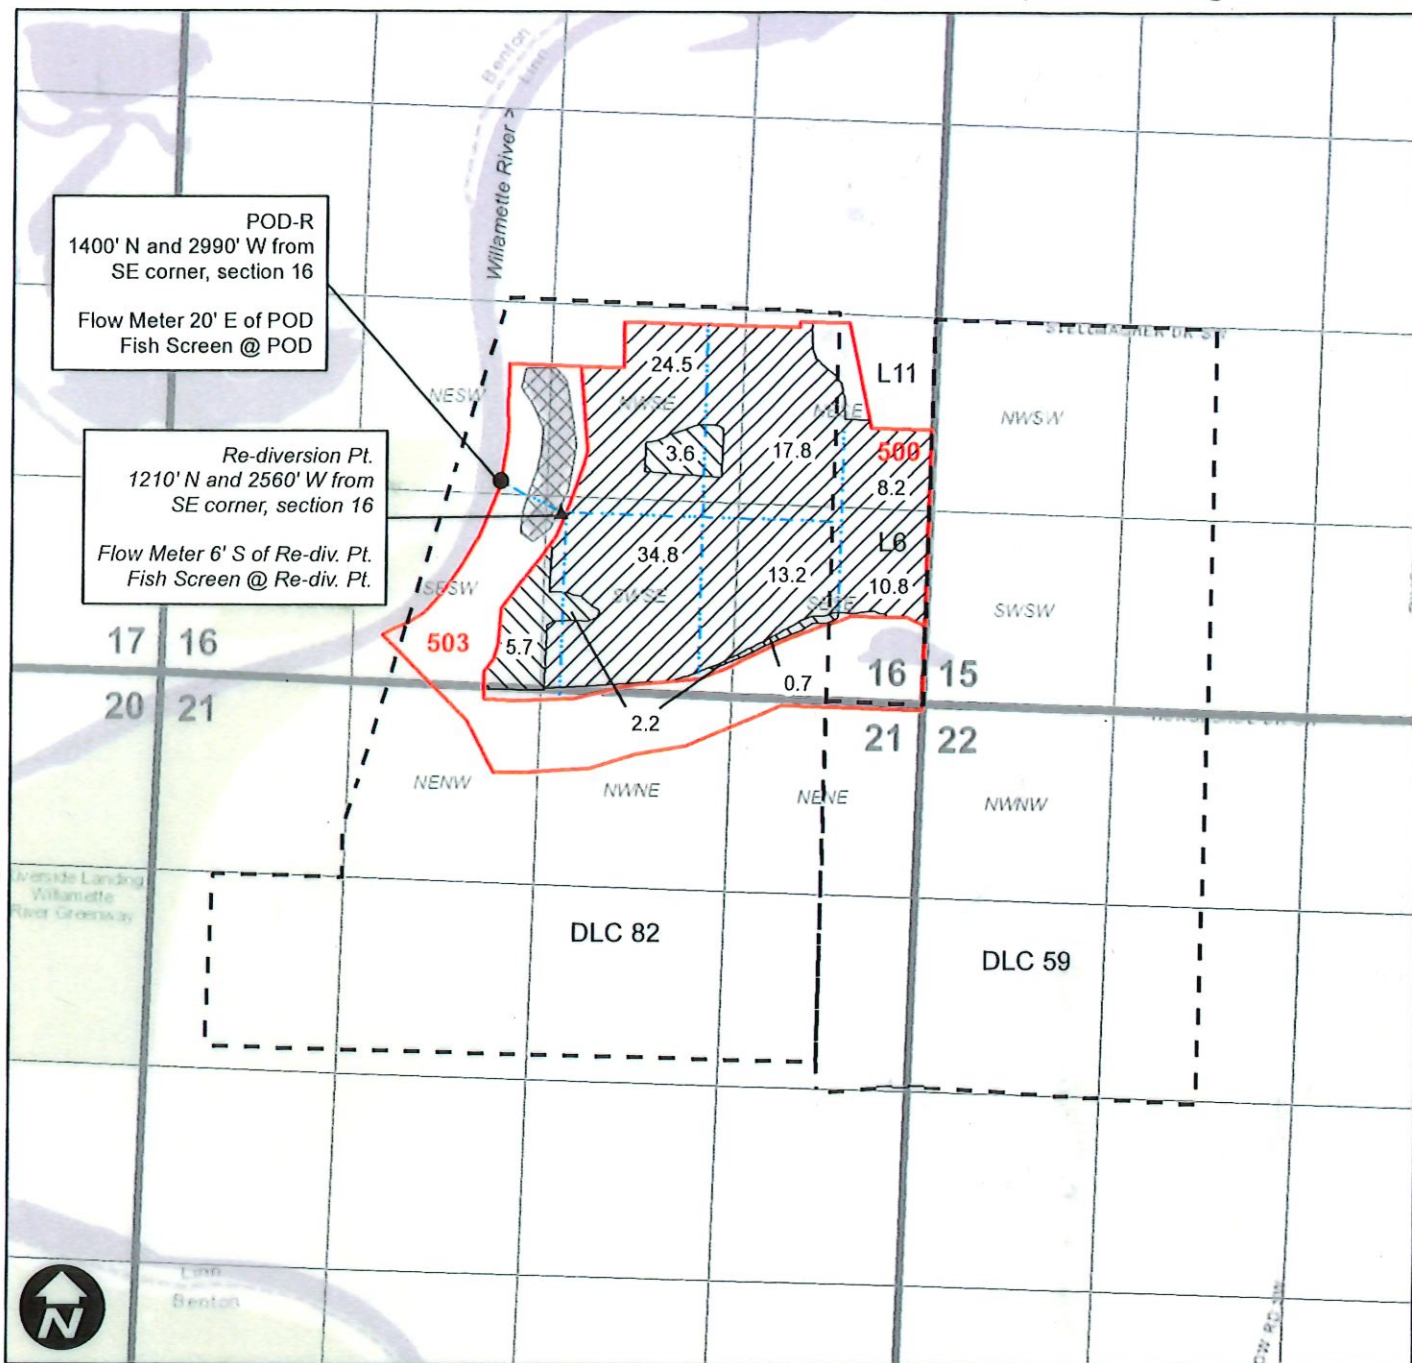

Legend

- POU IR
- Mainline
- Taxlots
- POU IS
- Bulge
- DLC

