

APPLICATION MAP FOR PERMANENT WATER RIGHT TRANSFER
POINT OF DIVERSION CHANGE
CERTIFICATE 51458 & PORTIONS OF 51520
SECTION 26, 27, & 34, TOWNSHIP 36 SOUTH, RANGE 4 WEST, W.M.

LEGEND

POINTS OF DIVERSION (POD)

POD#1 (PROPOSED) 1210 FT. N. & 130 FT. W. FROM SE. COR. SEC. 27.

POD#2 (AUTHORIZED) 80 FT. N. & 1110 FT. E. FROM S. 1/4 COR. SEC. 34.

REFERENCE POINT


IRRIGATION MAINLINE

TAXLOT BOUNDARIES

DONATION LAND CLAIM

1/16 SECTION LINES (AS PROJECTED)

PLACE OF USE (POU) IRRIGATION:

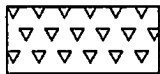

CERT. 51458



CERT. 51520
UNCHANGED



CERT. 51520
UNTIL JULY 1




CERT. 51520
FROM JULY 1

POU PER QUARTER-QUARTER

CERTIFICATE 51458				PORTION OF CERTIFICATE 51520			
T. 36 S., R. 4 W.				T. 36 S., R. 4 W.			
Sec.	Q-Q	GL / DLC	Acres	Until July 1			
26	(SW-SW)	DLC 37	0.2	Sec.	Q-Q	GL / DLC	Acres
27	(SW-NE)	DLC 41	1.1	34	(NE-NE)	DLC 41	12.5
27	(NE-SW)	DLC 41	1.5		(NW-NE)	DLC 41	13.1
27	(NW-SE)	DLC 41	20.8		(SW-NE)	DLC 41	15.0
27	(NW-SE)	GL 13	0.3		(SE-NE)	DLC 41	12.0
27	(SW-SE)	DLC 41	16.7	From July 1			
27	(SE-SE)	DLC 41	10.3	Sec.	Q-Q	GL / DLC	Acres
27	(SE-SE)	DLC 37	0.4	34	(NE-NE)	DLC 41	10.0
34	(NE-NE)	DLC 41	7.7		(SE-NE)	DLC 41	12.0



EXPIRES 06/30/2024

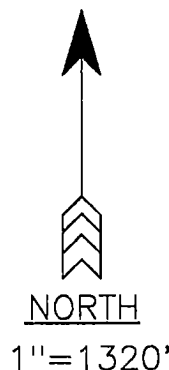

RECEIVED

JAN 19 2023

OWRD




P.O. Box 995
Coos Bay, OR 97420
(541) 297-1880
vancampconsulting@gmail.com

Prepared For:
Del Rio Vineyards
P.O. Box 906
Gold Hill, OR 97525


Project:
Permanent Change of
Point of Diversion
Transfer Map

Date:
DEC. 16, 2022

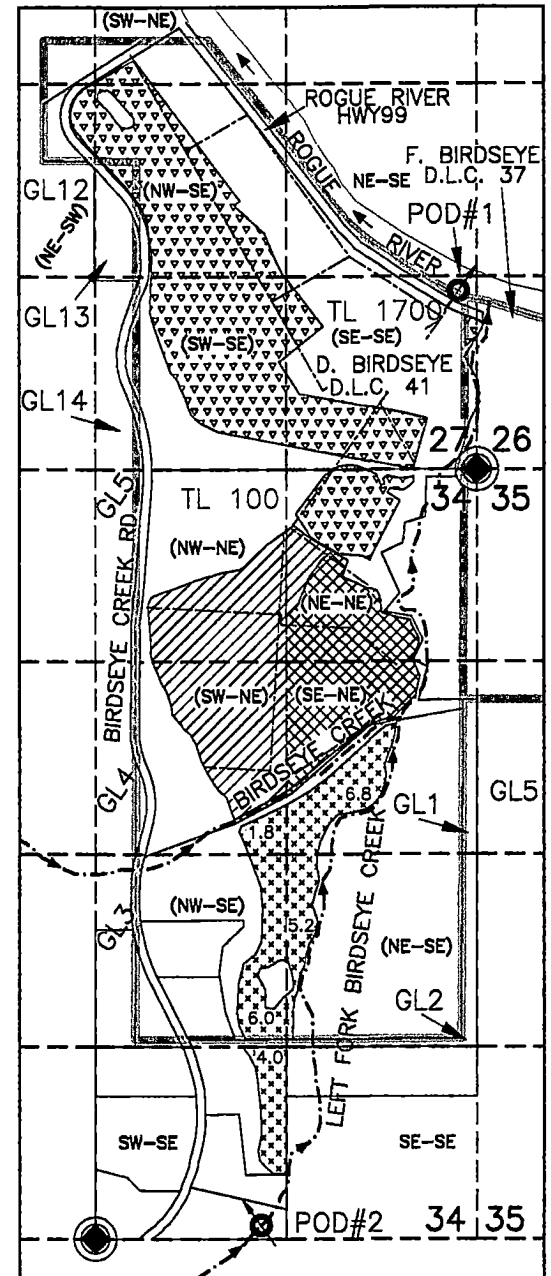

DISCLAIMER: THIS MAP WAS PREPARED FOR THE PURPOSE OF IDENTIFYING THE LOCATION OF WATER RIGHT ONLY AND IS NOT INTENDED TO PROVIDE LEGAL DESCRIPTIONS OR LOCATIONS OF PROPERTY LINES.

T.36S., R.4 W., W.M.

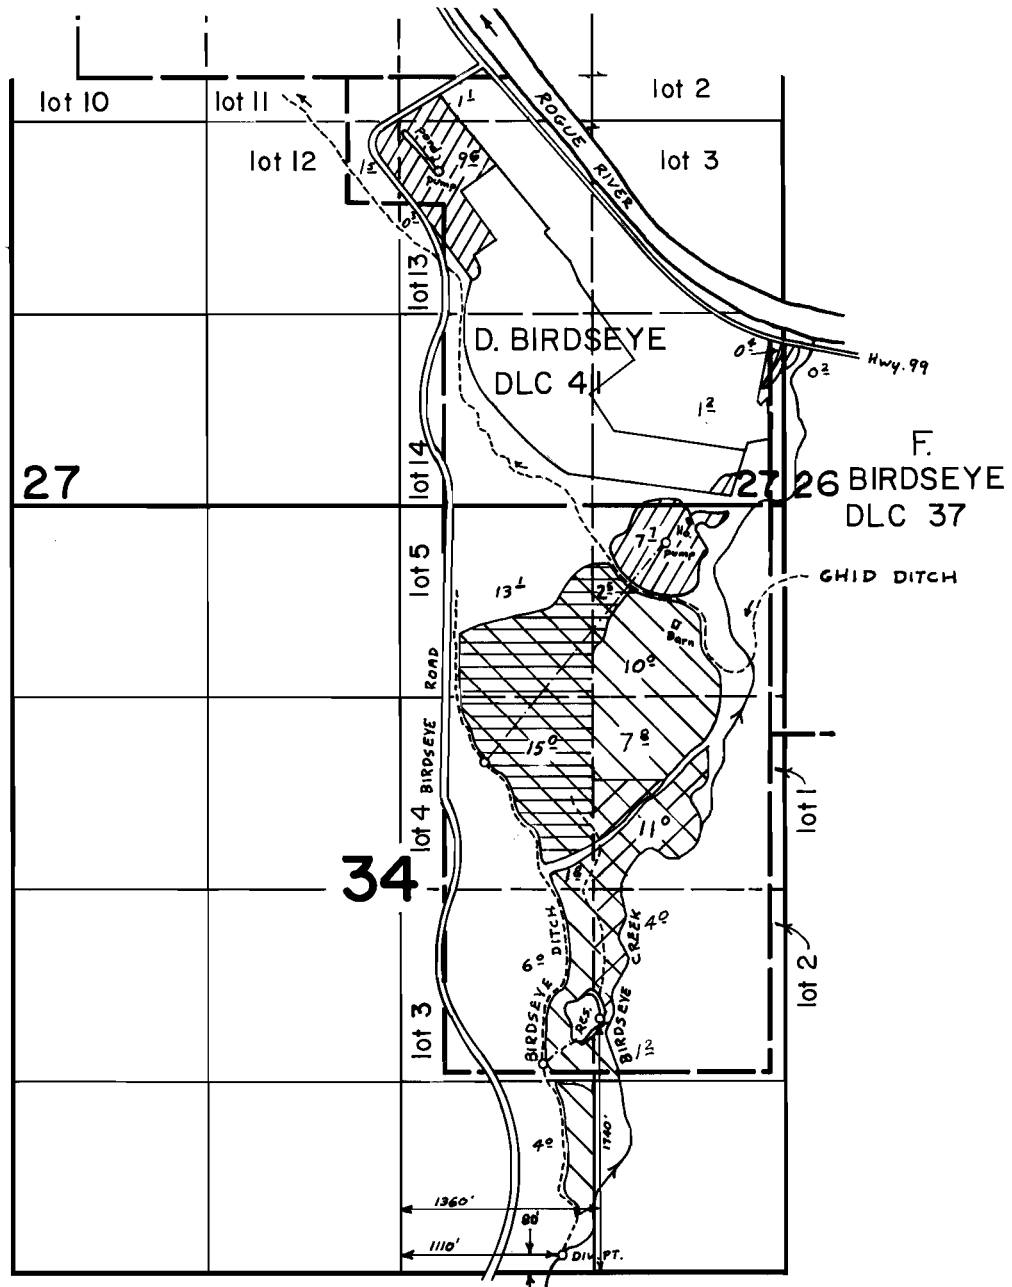

Scale 4" = 1 mile

FINAL PROOF SURVEY

UNDER

Transfer no. B-209 &

46626 34894

R-51696 R-6249

Application No. 51697... Permit No. 38833.....

IN NAME OF

.....GLENN C. BIRDSEYE.....

Surveyed July 15, 1980, by B.R. SUND.....


-  Tr. no. B-209
-  46626
-  46626 - July 1.
-  51697 supp'l.

RECEIVED

NOV 03 2022

OWRD

T.36S., R.4 W., W.M.

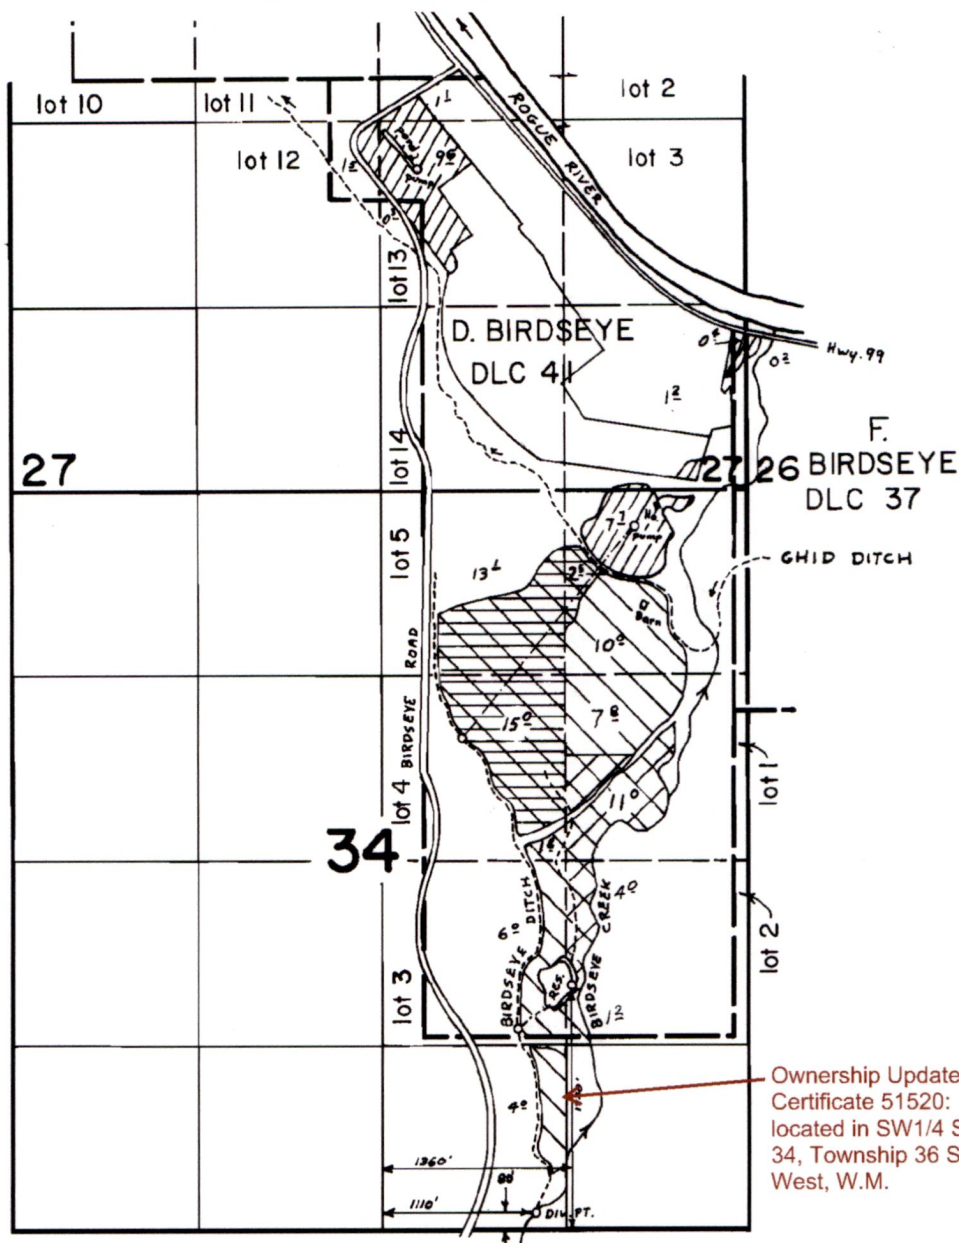

Scale 4" = 1 mile

FINAL PROOF SURVEY

UNDER

Transfer no. B-209 B

46626 34894

R-51696 R-6249

Application No. 51697... Permit No. 38833.....

IN NAME OF

GLENN C. BIRDSEYE

Surveyed July 15, 1980, by B.R.SUND

Tr. no. B-209

46626

46626 - July 1.

51697 supp'l.

14116

B50-10-3

BSJ

WB AGRICULTURAL LLC
1665 BIRDSEYE CREEK RD
GOLD HILL, OR 97525

CHANGE IN POINT OF
DIVERSION

CERTIFICATE 51520

SITUATED IN
SECTION 34, TOWNSHIP 36 S
RANGE 4 W, W.M.
JACKSON COUNTY OREGON

LEGEND

● C-51520 ORIGINAL POD
80' NORTH and 1110' EAST
OF SOUTH 1/4 CORNER
SECTION 34, T36S R4W

○ NEW POD
460' NORTH and 1300' EAST
OF SOUTH 1/4 CORNER
SECTION 34, T36S R4W



C-51520 POU (UNCHANGED)




C-51520 TIED TO NEW POD
4 ACS - SW SE SECTION 34

— BIRDSEYE DITCH


RECEIVED

NOV 03 2022

OWRD

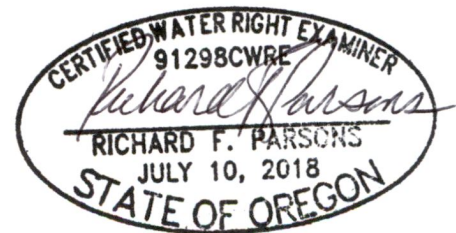

14116

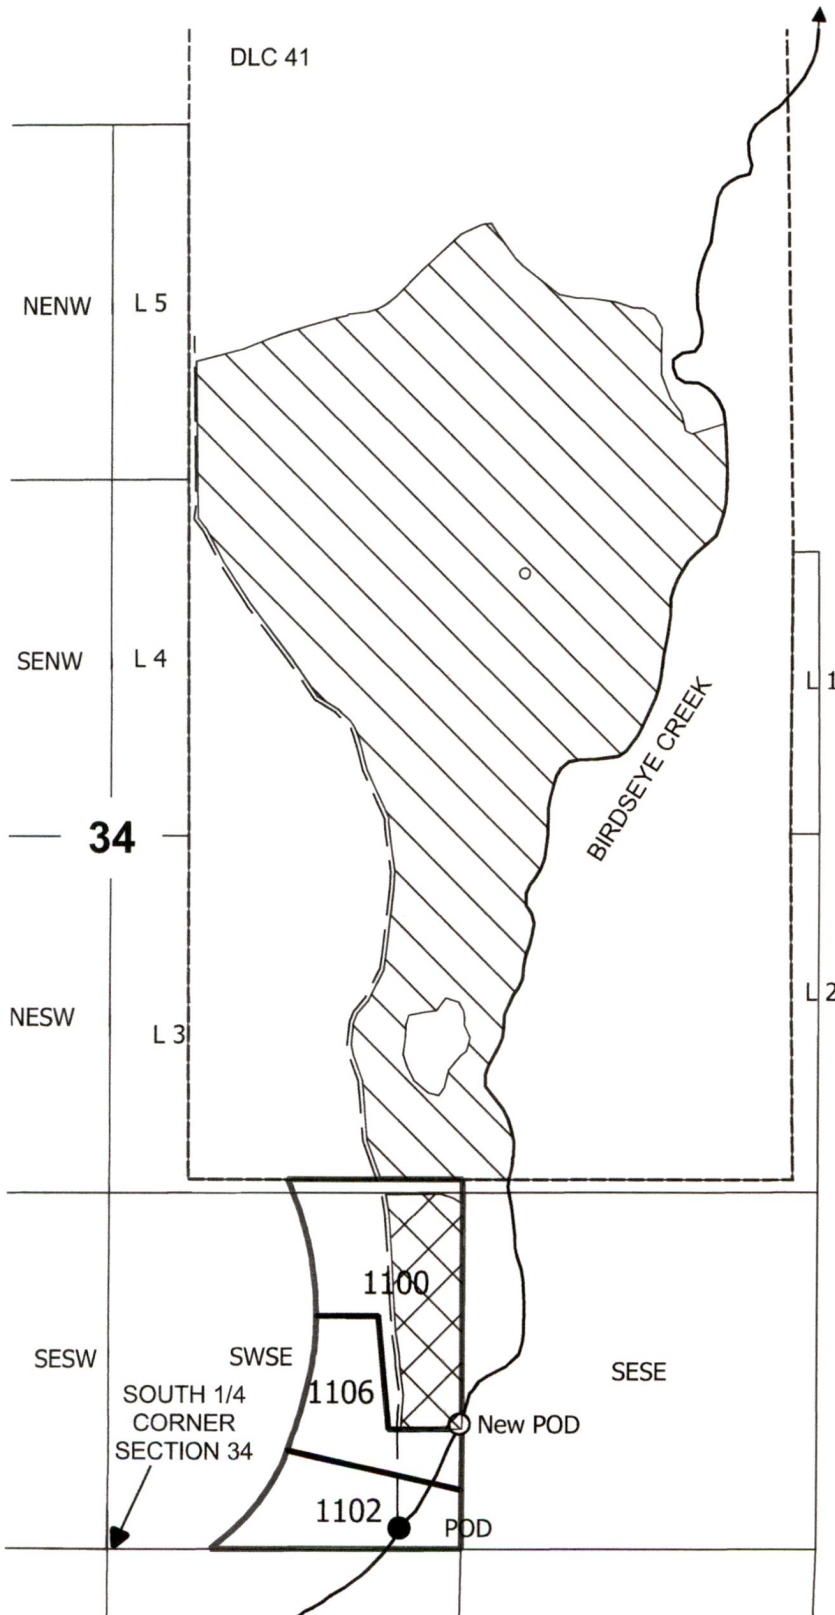

0 700 ft

This map is not intended to provide
legal dimensions or locations of
property ownership lines

ParsonsWater Consulting LLC
rick.parsons@parsonwater.com
541.499.0257 303.667.5067