

C-5/12

MAP FOR


Water Right Transfer - FROM Map

Section 3, T1S, R3W, Washington County

Cert. 94550



1 IN = 1320 FT
0 660 1320

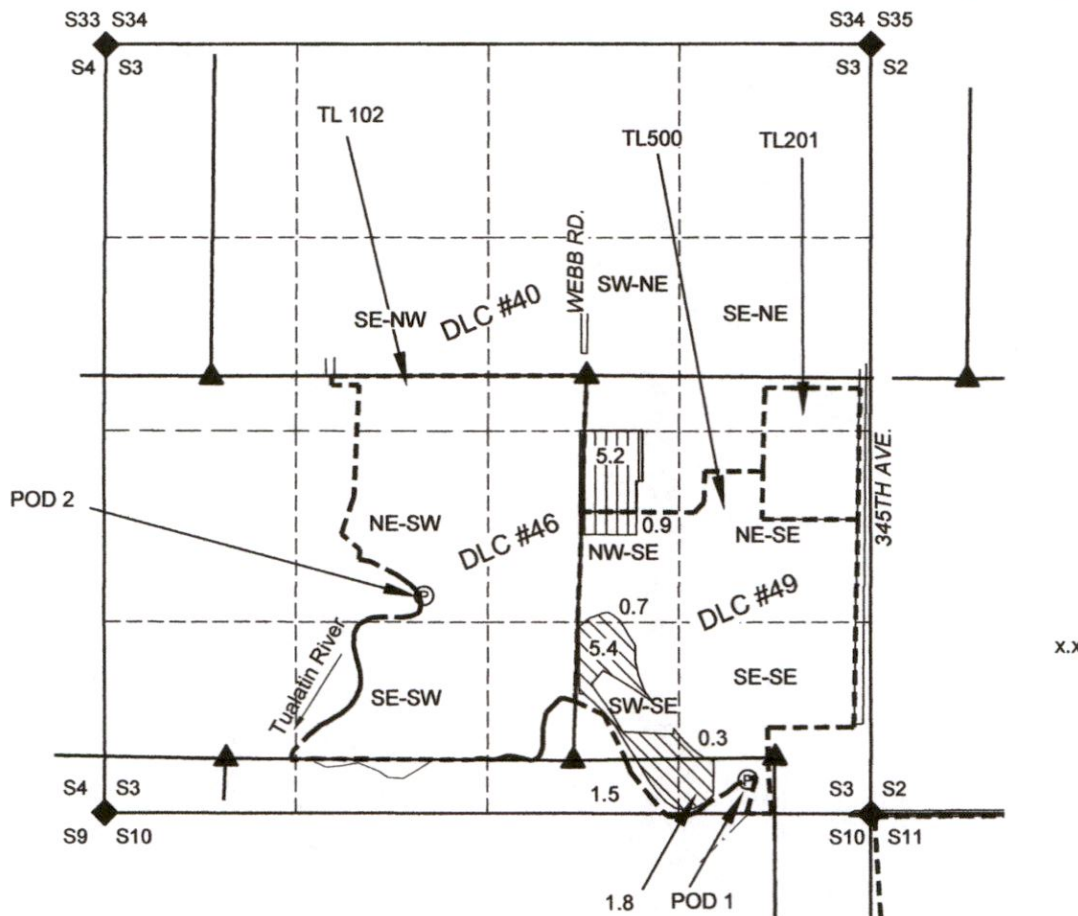

POD 2 IS 1500 FEET NORTH AND 3080 FEET WEST FROM THE SE CORNER SECTION 3.

NOTES:

THIS MAP IS NOT INTENDED TO PROVIDE LEGAL DIMENSIONS OR LOCATIONS OF PROPERTY OWNERSHIP LINES.

-Q-Q LINES ARE BASED ON TAX ASSESSOR MAP FOR SECTION 3 (CD), T1S, R3W, PROPERTY LINES ARE BASED ON SAID ASSESSOR MAP AND CERTIFICATE MAP FOR THE RIVER.

-WATER CONVEYANCE LINES ARE ALL WITHIN THE PROPERTY AND THEREFORE ARE NOT SHOWN.

LEGEND

- ▲ DONATION LAND CLAIM (DLC) CORNER
- ◆ STREAM OR SURFACE DRAINAGE
- Ⓟ SECTION CORNER
- Ⓟ POINT OF DIVERSION
- TAX LOT LINE
- SECTION LINE
- QUARTER-QUARTER LINE
- DLC LINES
- Q-Q QUARTER-QUARTER OF A SECTION

Cert 94550



13778


RECEIVED

JUL 13 2021

OWRD

MAP BY:
ASPEN RURAL LAND CONSULTING
ERIC URSTADT, PE, PLS
971-250-1520
Jan 2021
Speer-OB6E

T. 1 S. R. 3 W. W.M.

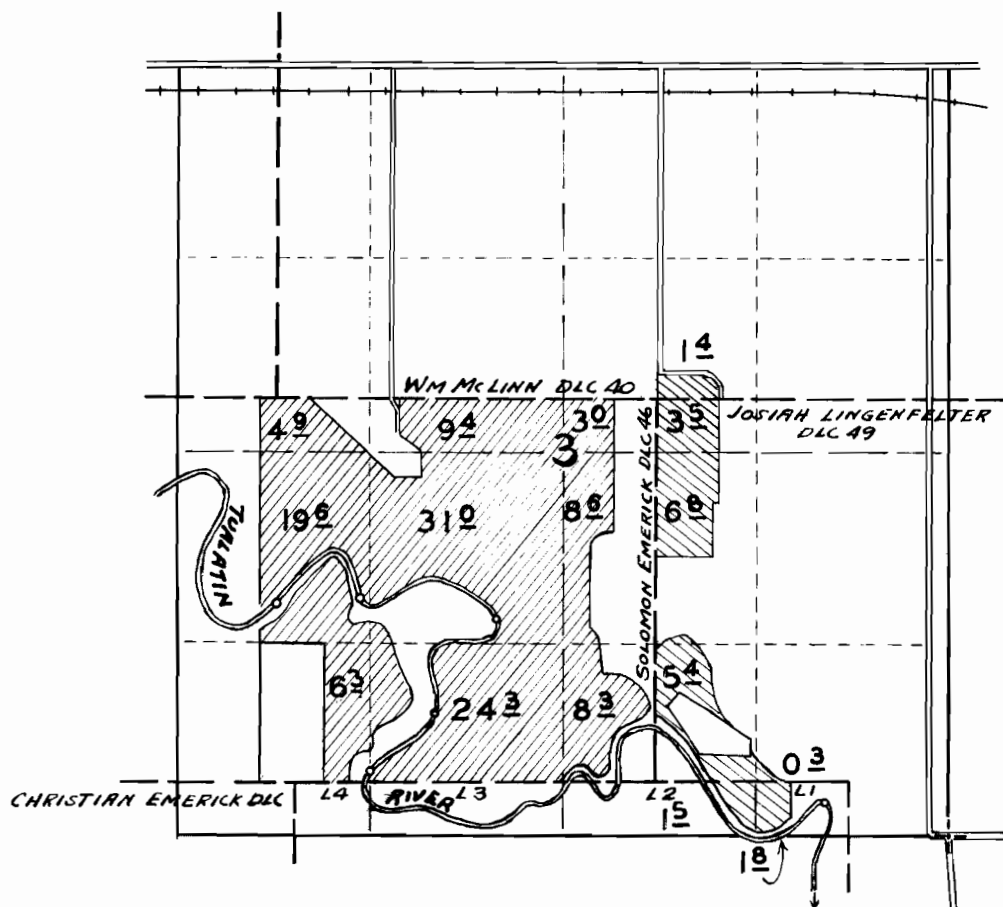

FINAL PROOF SURVEY

UNDER

26976

21189

Application No. 26203 Permit No. 20595

IN NAME OF

C. B. BUCHANAN, JR.

Surveyed 4-26 1956 by R. H. WHITEY.

ATT 7 - 1/3


MAP FOR

Water Right Transfer - FROM Map

RECEIVED BY OWNER Section 3, T1S, R3W, Washington County
Certs. 23038 & 88122


DEC 06 2017

1 IN = 1320 FT
0 660 1320

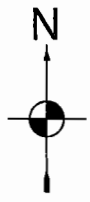

SALEM, OR

Q-Q	acres	cert	use	taxlot
NW-SE	0.9	23038	IRR	500
SW-NE	2.6	88122	IRR	102
SW-NE	2.7	88122	SUPP	102
SE-NE	4.0	88122	IRR	201
SE-NW	8.5	88122	SUPP	102
NE-SW	16.7	88122	SUPP	102
NE-SE	3.8	88122	IRR	201
NW-SE	3.0	88122	IRR	102
NW-SE	0.4	88122	IRR	500
NW-SE	8.6	88122	SUPP	102
NW-SE	0.8	88122	SUPP	500
SW-SE	0.3	88122	SUPP	102
SE-SE	0.2	88122	IRR	500
TOTALS	52.5			

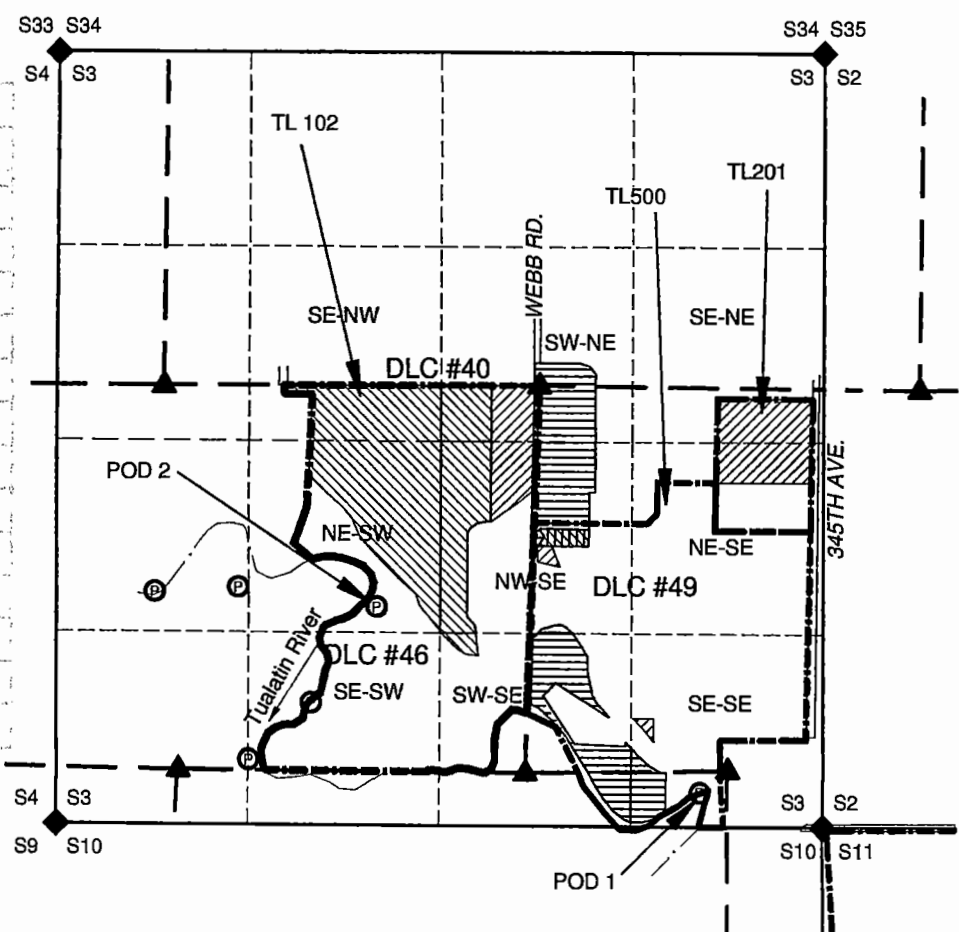

POD 1 IS 235' NORTH & 845' WEST FROM THE SE CORNER SECTION 3.

NOTES:

- THIS MAP IS NOT INTENDED TO PROVIDE LEGAL DIMENSIONS OR LOCATIONS OF PROPERTY OWNERSHIP LINES.
- THE REMAINING PORTIONS OF CERT 88122 (TVID) ARE NOT SHOWN DUE TO THE RELATIVELY SIZE OF THE LARGE RIGHT RIGHT.
- PROPERTY LINES AND Q-Q LINES ARE BASED ON TAX ASSESSOR MAP FOR SECTION 3 (CD), T1S, R3W.
- WATER CONVEYANCE LINES ARE ALL WITHIN THE PROPERTY AND THEREFORE ARE NOT SHOWN.



LEGEND

- ▲ DONATION LAND CLAIM (DLC) CORNER
- ◆ STREAM OR SURFACE DRAINAGE
- ◆ SECTION CORNER
- POINT OF DIVERSION
- TAX LOT LINE
- SECTION LINE
- QUARTER-QUARTER LINE
- DLC LINES
- QUARTER-QUARTER OF A SECTION

- Cert 23038 Moving Not moving
- Cert 88122 (TVID) Primary
- Cert 88122 (TVID) Supplemental

MAP BY:
ASPEN RURAL LAND CONSULTING
ERIC URSTADT, PE, PLS
971-250-1520
Sep 2017
Speer3H