


T. 1 S., R. 2 W., W.M.

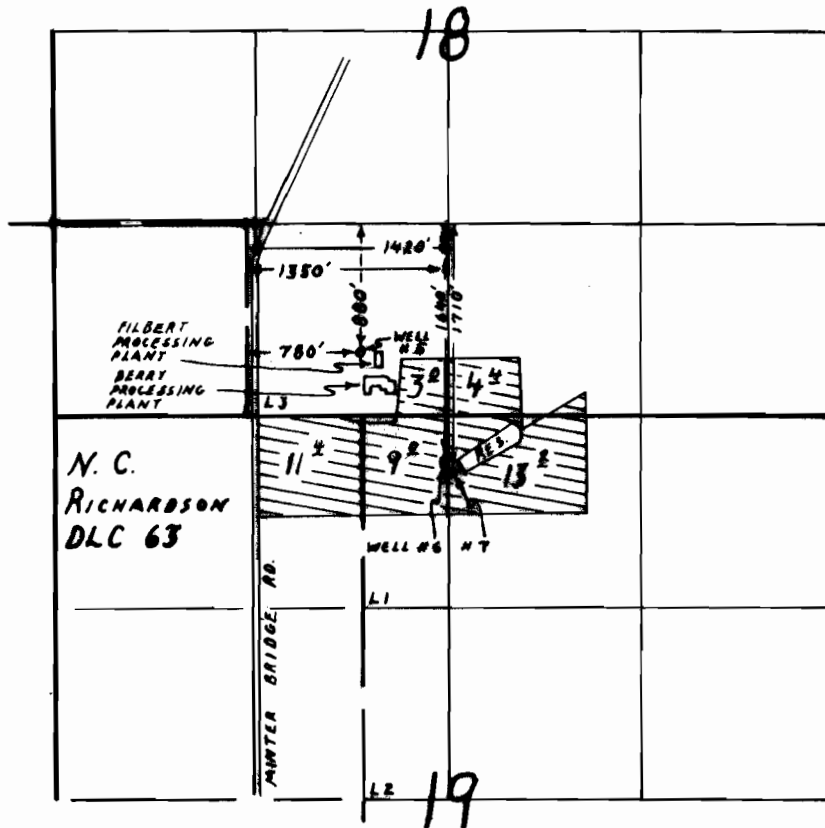

FINAL PROOF SURVEY
UNDER

Application No. G-11597 Permit No. G-10711
IN NAME OF

OREGON BERRY PACKING COMPANY

Surveyed July 14, 1993, by R.W. Klassen