


MAP FOR


Claim of Beneficial Use

S25, T3S, R1E, CLACKAMAS COUNTY**Appl S-88240, Permit S-55075**

1 IN = 600 FT



A horizontal scale bar with a black and white striped pattern. It is marked with the numbers 0, 300, and 600 at regular intervals.

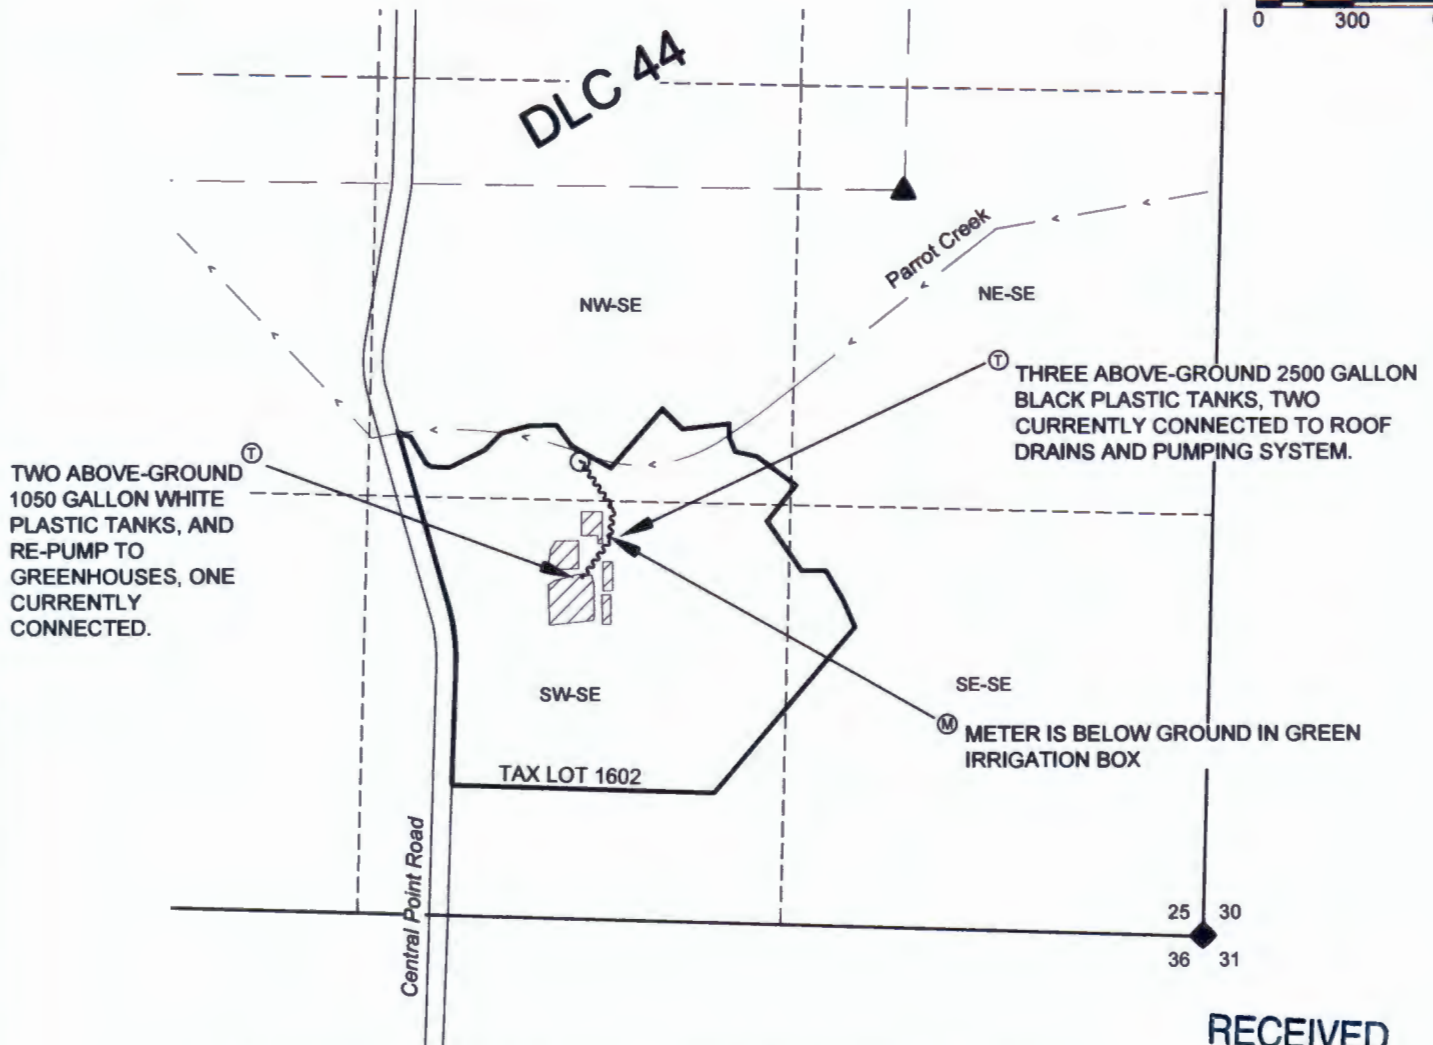

THE POD IS 845 FEET SOUTH AND 1015 FEET WEST OF THE SE CORNER OF DLC 44.

NOTES:

- THIS MAP IS NOT INTENDED TO PROVIDE LEGAL DIMENSIONS OR LOCATIONS OF PROPERTY OWNERSHIP LINES.
- PROPERTY LINES AND QUARTER-QUARTER LINES ARE BASED ON THE TAX ASSESSOR MAP FOR SECTION 25, T3S, R1E.
- WATER CONVEYANCE LINES SHALL BE ALL WITHIN THE PROPERTY AND THEREFORE ARE NOT SHOWN.

LEGEND



RECEIVED

MAR 18 2024

OWRD



Exp. 30 JUN 2024

MAP BY:

**ASPEN RURAL LAND
CONSULTING**

ERIC URSTADT, PE, PLS

971-250-1520

Feb 2024

GnomeGrown2C