



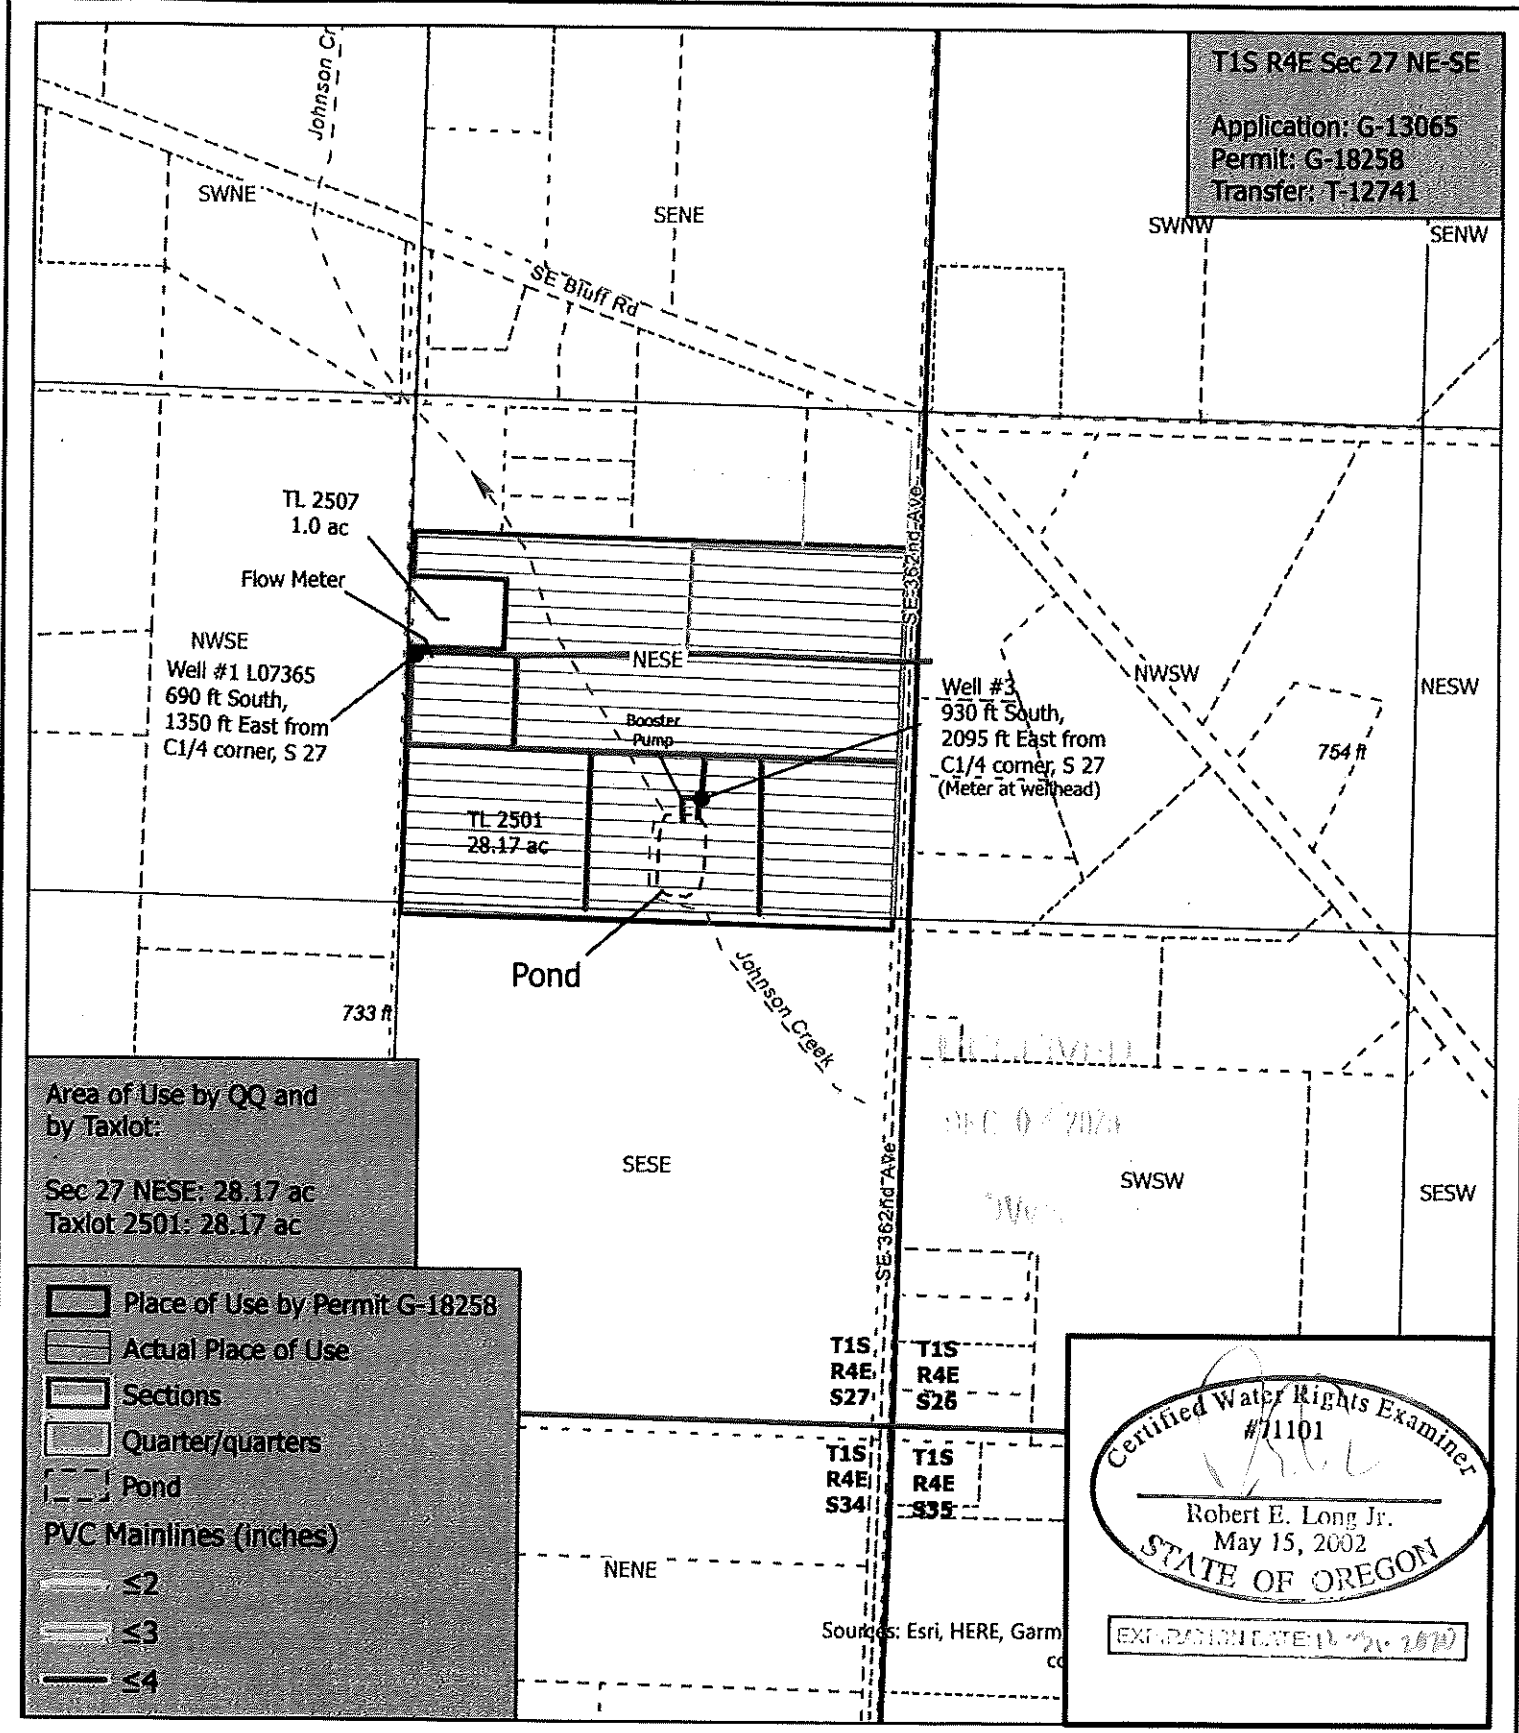

1319 SE MLK, Jr. Blvd, Suite 204
Portland, Oregon 97214
(503) 954-1328

This map is not intended to provide legal dimensions or locations of property ownership lines.

1	DATE	AUTH	DRAFT
1	9/16/20	IAG	Draft
2	9/16/20	REL	Comments/Edits
No.	Date	By	Revisions

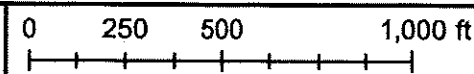

Project # 1709002
Trees NW
Trees NW
9720 SE 362nd Ave
Boring, Oregon 97009

