

CLAIM OF BENEFICIAL USE AND FINAL PROOF MAP



FOR
HIGH COUNTRY RANCH ROADS
AND PARKS ASSOCIATION

T35S, R14E SECTIONS 7 & 8 W.M.

KLAMATH COUNTY, OREGON

APPLICATION R-87853

PERMIT R-15293

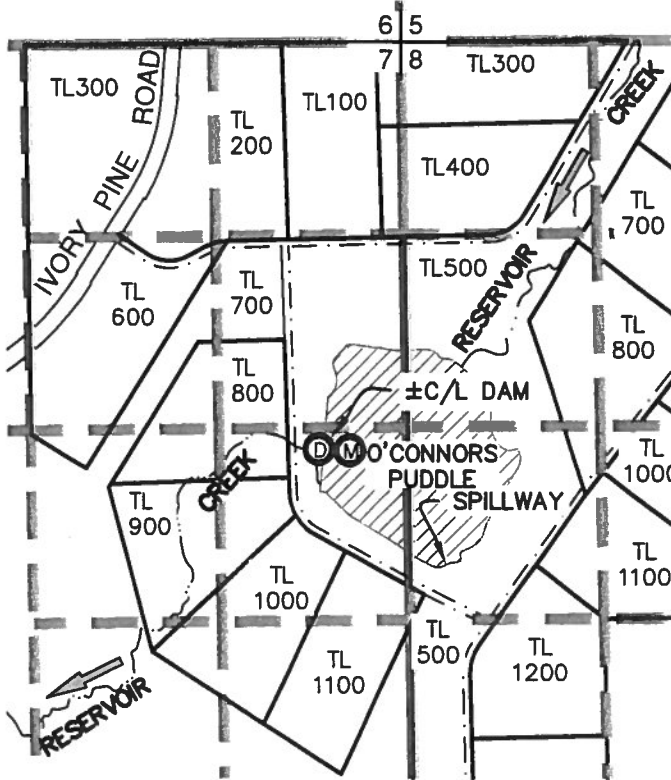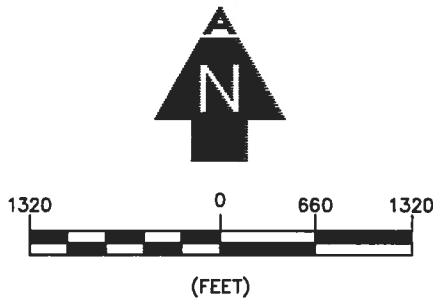

C/L DAM TIE:

±2,750 SOUTH AND ±580'
WEST FROM THE NE CORNER OF
SECTION 7, T35S, R14E W.M.

NOTES:

1. THIS MAP WAS PREPARED FROM NAIP 2005 AERIAL PHOTOGRAPH, KLAMATH COUNTY TAX MAPS AND OREGON GLO MAPS.
2. THE PURPOSE OF THIS MAP IS TO IDENTIFY THE LOCATION OF THE WATER RIGHT ONLY, AND IS NOT INTENDED TO PROVIDE DIMENSIONS OR LOCATION OF PROPERTY LINES.
3. A PORTION OF THE STORAGE (11.0af.) IS PERMITTED UNDER CERTIFICATE 85821.
4. PROPOSED USE: RECREATION, FISH AND WILDLIFE.
5. THE DATE OF PRIORITY FOR THIS PERMIT IS JANUARY 18, 2018.


LEGEND

	SECTION LINE
	1/4 1/4 LINE
	TAX LOT LINE
	CANAL/CREEK
	ROAD EASEMENT LINE
	FLOW DIRECTION
	SECTION CORNER
	TAX LOT NUMBER
	POINT OF DIVERSION
	SUITABLE MEASURING DEVICE
	RESERVOIR

Keith Hicks

OWNER SIGNATURE

OWNER SIGNATURE

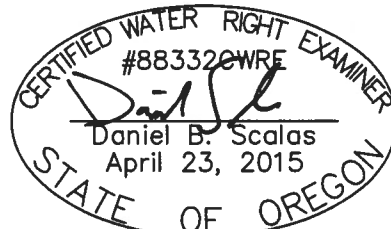

RENEWAL 06/30/20

ADKINS

CONSULTING
ENGINEERING, L.L.P.

Engineers ▲ Planners ▲ Surveyors

1435 Esplanade Ave · Klamath Falls, Oregon 97601 · (541) 884-4666 · FAX (541) 884-5335

Oregon · California

9/14/18

COBU

3122-01

**CLAIM OF BENEFICIAL USE
AND FINAL PROOF MAP**

FOR
HIGH COUNTRY RANCH
ROADS AND PARKS ASSOCIATION
T35S, R14E, SECTIONS 7 & 8 W.M.
KLAMATH COUNTY, OREGON
APPLICATION R-87853
PERMIT R-15293