

SECTION 14 T.1 S., R.3 W., W.M.

WASHINGTON COUNTY, OREGON

11 12
14 13

1/4 COR

POINT OF DIV.
25'S & 400'E
N 1/4 COR.
SEC. 14

TUALATIN RIVER

WATER RESOURCES DEPT.
SALEM, OREGON

AUG 3 0 2000

RECEIVED

SCALE: 1"=400'

MAP BASE:
ASSESSORS MAP
1996 SCALED PHOTO

LOT 2

T.L. 100

12.4 Ac

10.3 AC

11.5 Ac

26.4 Ac

LOT 1

LANE

TONGUE

N.W. COR
DLC 57

FINAL PROOF SURVEY

UNDER

APPLICATION S-80141

PERMIT 52051

SURVEYED AUGUST 16, 2000

PREPERATION OF THIS MAP IS FOR THE
PURPOSE OF IDENTIFYING THE LOCATION OF
THE WATER RIGHT ONLY. THERE IS NO INTENT
TO PROVIDE DIMENSIONS OR LOCATION OF
PROPERTY OWNERSHIP LINES.



GLENN WALTERS NURSERY, INC.

P.O. BOX 280
BANKS, OR

date	by	designed	drawn	checked	drawing no.	sheet no.
8/21/00	WRV				00-A-16	1
8/21/00	WRV					1
8/21/00	WRV					1


VERBOORT ENGINEERING

AGRICULTURE · CIVIL · WATER RESOURCES
HILLSBORO, OREGON

RECEIVED

MAR 22 1995

WATER RESOURCES DEPT.
SALEM, OREGON

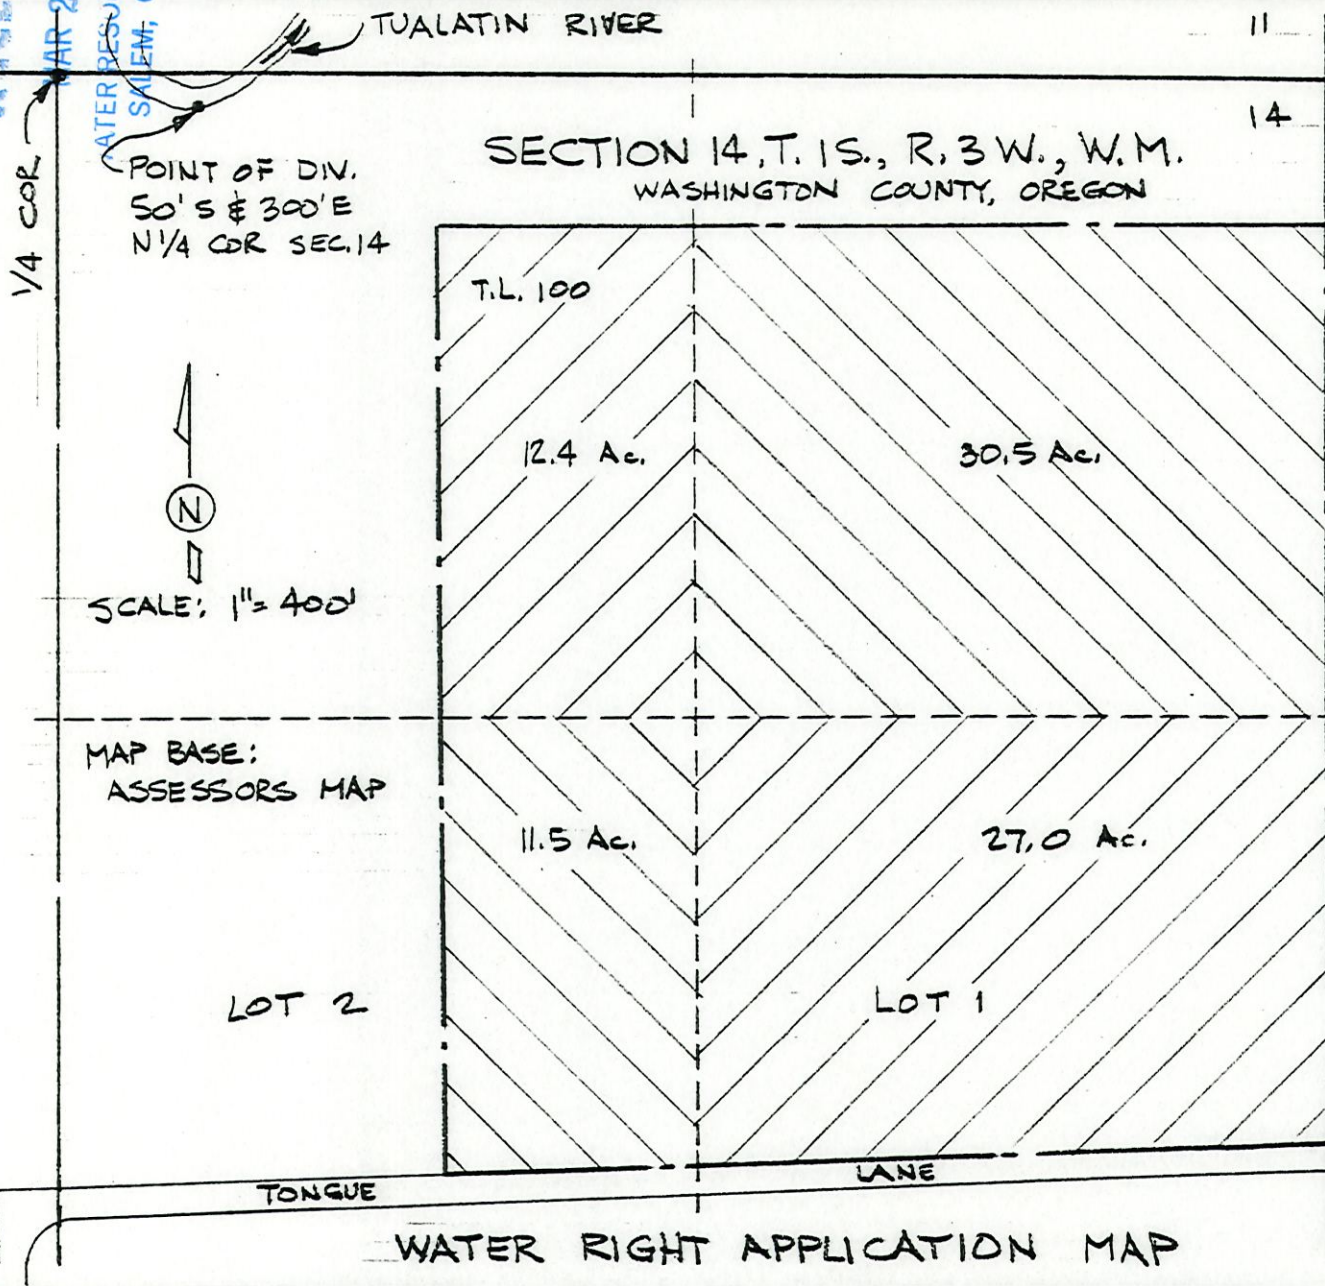

Application No. 5-80141
Permit No. 52051

PREPARATION OF THIS MAP IS FOR THE
PURPOSE OF IDENTIFYING THE LOCATION OF
THE WATER RIGHT ONLY. THERE IS NO INTENT
TO PROVIDE DIMENSIONS OR LOCATION OF
PROPERTY OWNERSHIP LINES.



by	date
WRN 2.95	WRN 2.95
designed	drawn
checked	checked
WRN 2.95	WRN 2.95
drawing no.	95-A-01
sheet no.	1/1

VERBOORT ENGINEERING
AGRICULTURE-CIVIL-WATER RESOURCES
HILLSBORO, OREGON

GLENN WALTERS NURSERY, INC.
P.O. BOX 280
BANKS, OR

WATER RIGHT APPLICATION MAP