

CLAIM OF BENEFICIAL USE BSA CAMP BAKER

LEGEND

-  SECTION LINE
-  1/4 SECTION LINE
-  TAX LOT LINE
-  1" PVC WATER (DIST)
-  2" OR 4" PVC WATER DISTRIBUTION MAIN
-  2" PVC WATER SUPPLY



EXISTING STRUCTURE



EXISTING CAMPSITE
WITH WATER SERVICE

NOTE: ALL NAMED STRUCTURES HAVE
WATER SERVICE FROM THIS SYSTEM

PUMPHOUSE ALSO CONTAINS 3 -
1500 GAL STORAGE TANKS AS WELL
AS PRESSURE TANKS & WATER
TREATMENT EQUIPMENT.

POD - 1538' NORTH &
786' WEST OF S 1/4
CORNER SECTION 26,
T.19 S. R.12 W.



SCALE: 1" = 1320'





PERMIT # S-54677
APPLICATION # S-87581
OWNER: OREGON TRAIL COUNCIL INC
PERMIT HOLDER: OREGON TRAIL COUNCIL INC

Boeger & Associates LLC

1011 S. Bertelsen Rd
Eugene, OR 97402
Ph: 541.302.4996
Fax: 541.302.4968
dboeger@boegerassociates.com
JOB No.: 393

NW 1/4, SEC 26, T19S, R12W, W.M.
TM 19-12-26-20, TL 101
SE & SW 1/4, SEC 26, T19S, R12W, W.M.
TM 19-12-26-30, TL 100
NE 1/4, SEC 35, T19S, R12W, W.M.
TM 19-12-35-10, TL 400, 401, 601

AUGUST 5, 2022

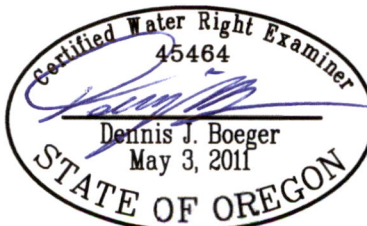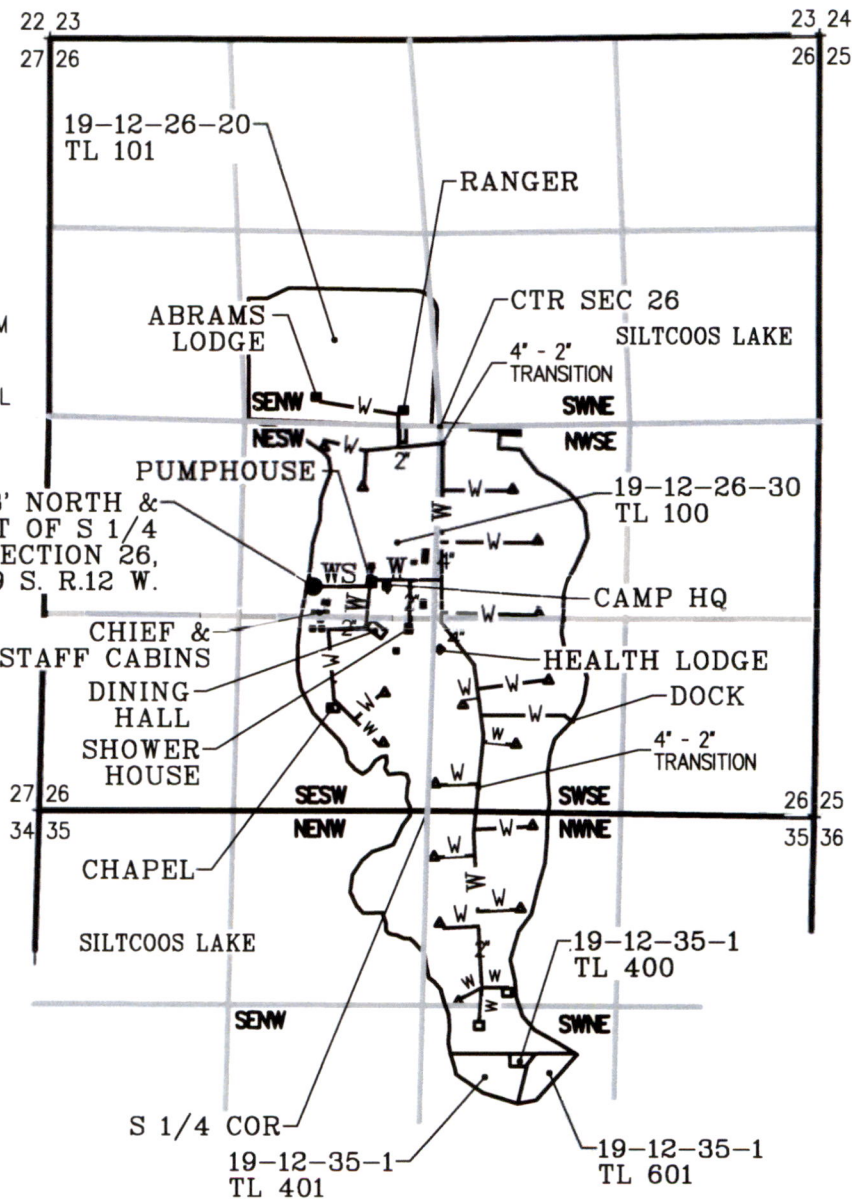

EXPIRES: 12/31/2023

DISCLAIMER

THIS MAP IS NOT INTENDED TO PROVIDE
LEGAL DIMENSIONS OR LOCATIONS OF
PROPERTY OWNERSHIP LINES.