


TOWNSHIP 16 SOUTH, RANGE 22 EAST, W.M.

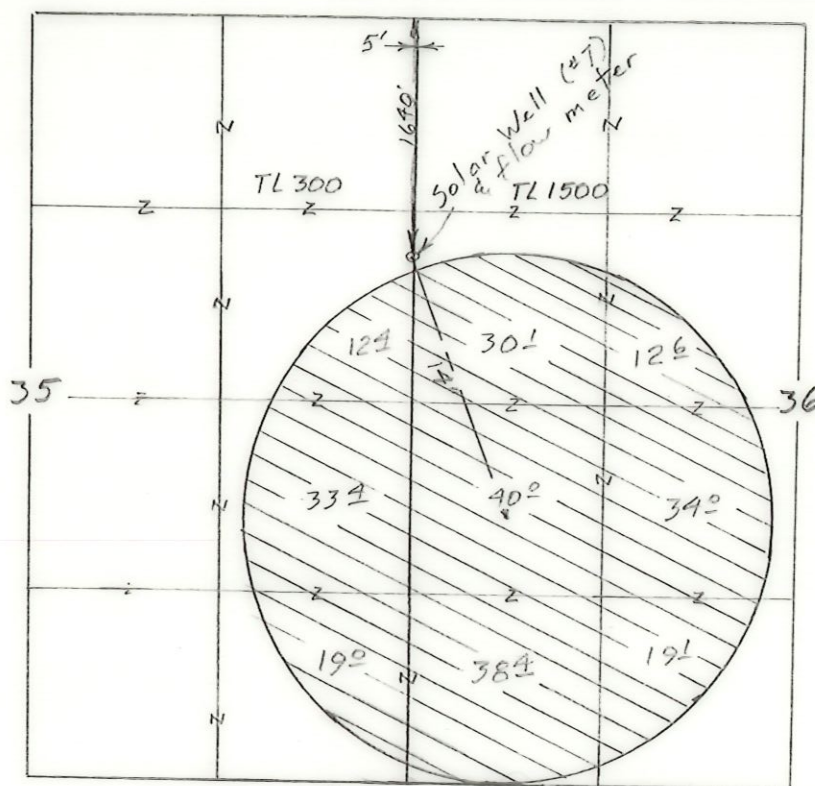

Scale 1" = 1320'
(4" = 1 mile)

Surveyed March 8, 2014

⊙ irrigation 239⁰ acres

App G-16907

Per G-16508

Claim of Beneficial Use Map


for

Gutierrez Cattle Co.

RECEIVED BY OWRD

AUG 01 2014

SALEM, OR

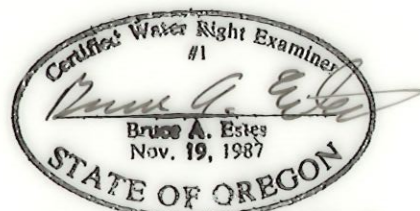

Renewal Dec 31, 2015

This map is for the purpose of
locating a water right only
and has no intent to provide
legal dimensions or the location
of property lines.

ESTES SURVEYS, LLC

PO Box 17518
Salem, OR 97306-7518
(503) 565-7593

80382 Arnold Rd
Bend, OR 97702
(541) 382-7391