


TOWNSHIP 16 SOUTH, RANGE 22 EAST, W.M.

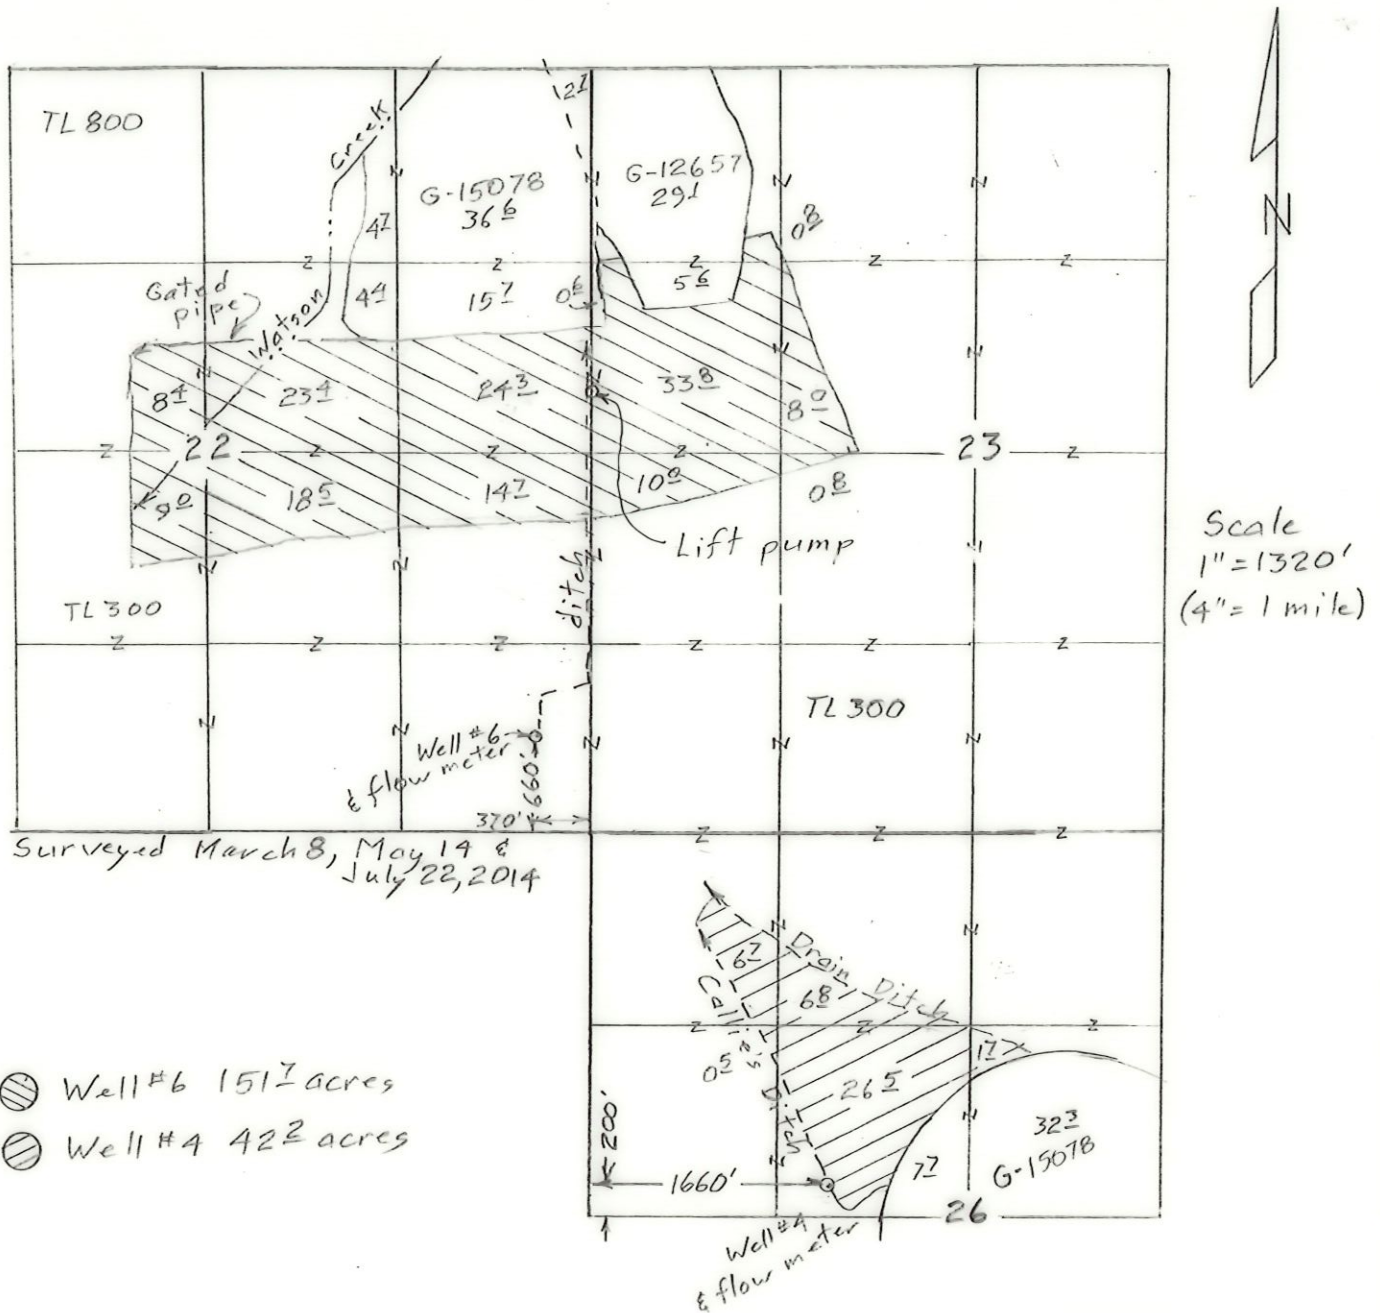


Claim of Beneficial Use Map
for
Gutierrez Cattle Co.

RECEIVED BY OWRD

AUG 01 2014

SALEM, OR



App G-16915
Per G-16774

This map is for the purpose of
locating a water right only
and has no intent to provide
legal dimensions or the location
of property lines.

ESTES SURVEYS, LLC

PO Box 17519 60362 Arnold Rd
Salem, OR 97306-7519 Bend, OR 97702
(503) 565-7593 (541) 382-7391