


T23S R32E, WM
HARNEY COUNTY, OREGON

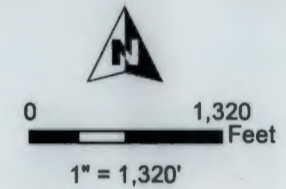

- Well & Meter
- Pipeline
- Flood Irrigation Ditch
- POU IS (Ap G-17284 Priority 11-6-2009)
- POU IR (Ap G-17284 Priority 11-6-2009)
- Township
- Sections
- Quarter Quarter
- Tax Lots


RECEIVED

FEB 03 2021


OWRD

WELL LOCATION:

1 (HARN 51617/L-100269) - 330' N, 860' E
of NE Cor Sec 24

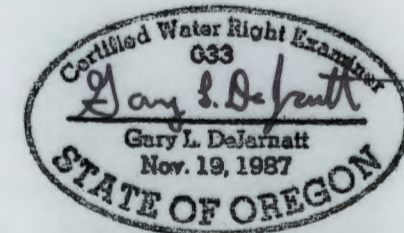

RENEWAL DATE 12/31/2021

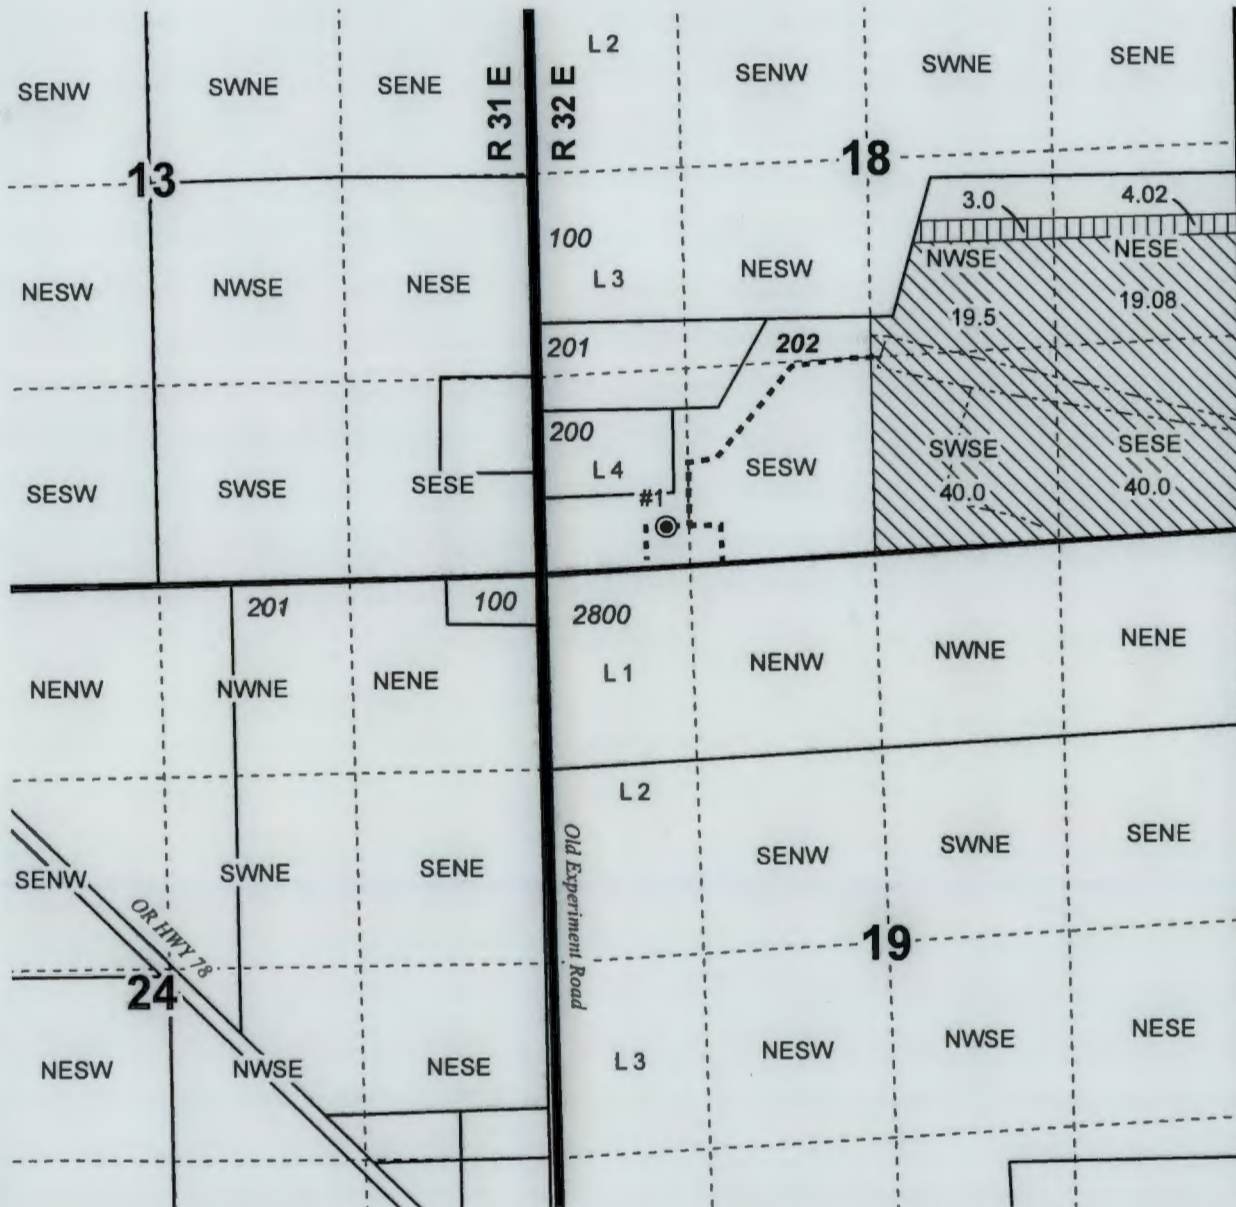

CLAIM OF BENEFICIAL USE MAP
Steve & Kristi Rickman

Ap G-17284/T-12749 Permit G-18263

NOTE: THIS MAP IS NOT INTENDED TO
PROVIDE LEGAL DIMENSIONS OR LOCATIONS
OF PROPERTY OWNERSHIP LINES.

PROJECT #20082

Date: 1/8/2021

WATER RIGHT SERVICES, LLC

PO BOX 1830, BEND, OR 97709

CCB# 197121 www.oregonwater.us

541-389-2837 JOHNSHORT@USA.COM