


CLAIM OF BENEFICIAL USE MAP

TO ADD PLACE OF USE AND A POINT OF APPROPRIATION
FOR APPLICATION G-17686

WEST 1/2 OF SECTION 16 AND EAST 1/2 OF SECTION 17,
TOWNSHIP 36 SOUTH, RANGE 24 EAST, W.M.
TAX LOTS: 3400 AND 3800

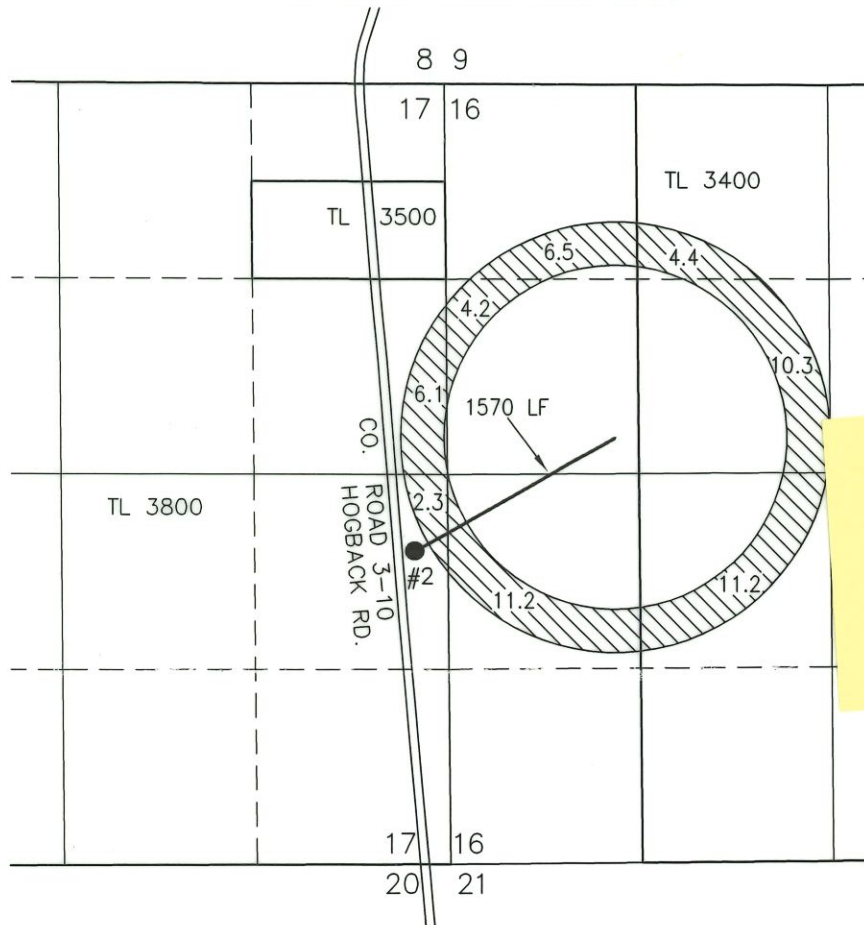


 56.2 AC IR FROM POA2
(PERMIT G18083)

 CONVEYANCE

● POA 2 (LAKE 1840)

LOCATED IN THE NE 1/4 SE 1/4 SECTION 17, T36S
R24E, W.M. AND 2145 FEET NORTH AND 235 FEET
WEST FROM THE SE CORNER OF SECTION 17. FLOW
METER LOCATED 20 FEET EAST ON DELIVERY PIPE.

THIS MAP IS FOR THE PURPOSE OF LOCATING A WATER RIGHT
ONLY AND HAS NO INTENT TO PROVIDE LEGAL DIMENSIONS OR
THE LOCATION OF PROPERTY LINES

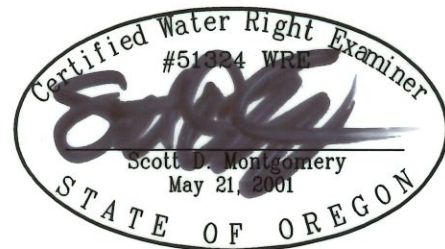

RENEWAL DATE: 12/31/2026

PREPARED FOR:

FITZGERALD RANCH, INC.
27493 HOGBACK ROAD
PLUSH, OR 97637

PREPARED BY:



ALL POINTS ENGINEERING AND SURVEYING, INC.
P.O. BOX 767 TERREBONNE, OR 97760
(541) 548-5833 www.APEandS.com