



CLAIM OF BENEFICIAL USE MAP
FOR APPLICATION G-15341 PERMIT G-15396
IN THE NAME OF ALAN CLEAVER
SECTIONS 27, 34, & 35, T5N, R26E W.M.
MORROW COUNTY

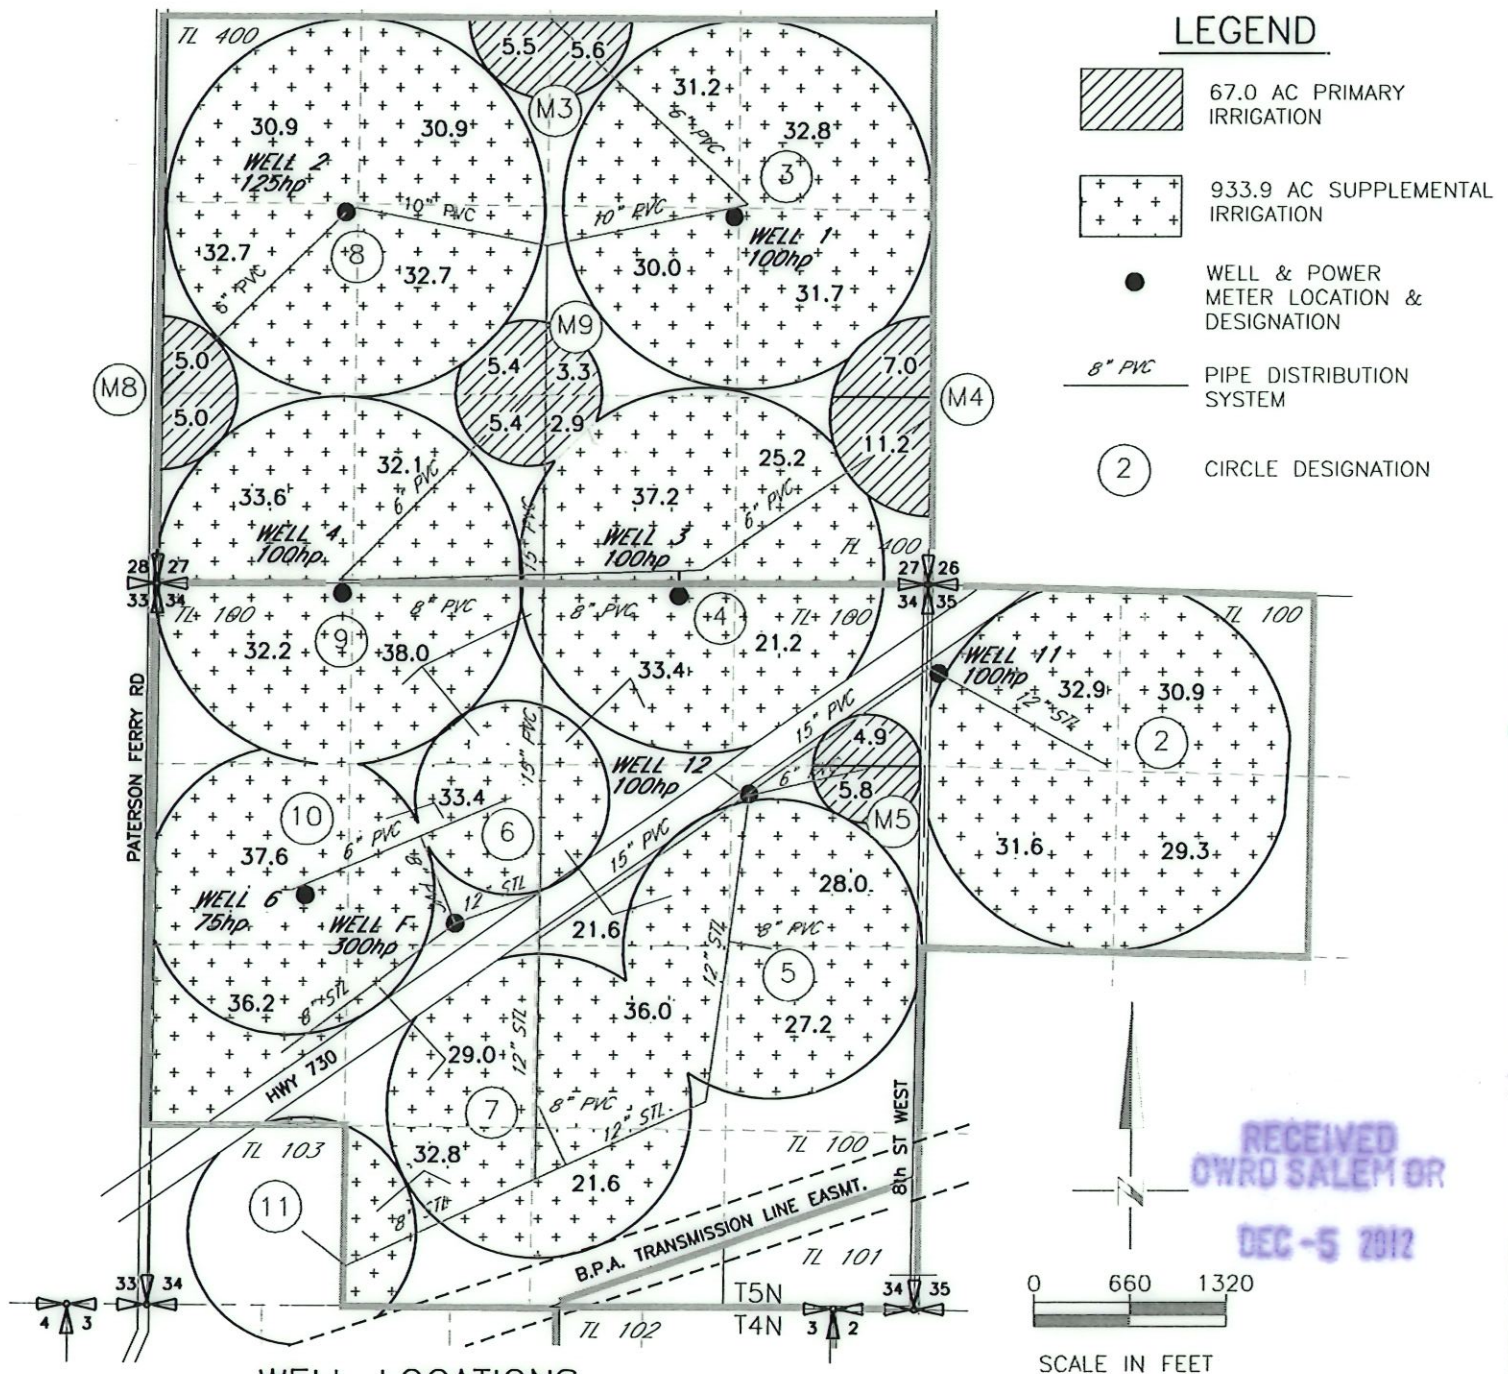

RECEIVED
OWRO SALEM OR
DEC-5 2012

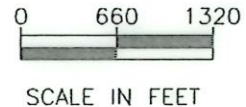

Certified Water Right Examiner
#333 WRE
Dale G. VanScheick
May 19, 1992
STATE OF OREGON
Renewal 4/30/14