


T.4S. R.2E. Sec. 31 & 32, and T.5S. R.2E. Sec. 5 & 6, W.M.

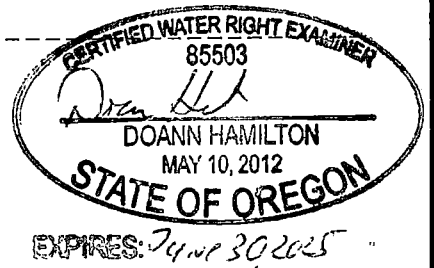

Barnard
DLC 42

0.1 GIVE

TL 5 2E 6 303

0.6

0.2

3" mainline

T.4S.

Lot 5

31

32

S. Barnards Road

T.5S.

6

5

Well
(CLAC 20566)
and meter

Barnard
DLC 37

State Highway 213

Well (CLAC 20566) is located 65 feet south and 35 feet east from the NW corner, Section 5.


 Area (0.8 Acres) irrigated under Application G-16795, Permit G-16307.

----- Tax lot boundary

 Donation Land Claim boundary

..... Water main line

Scale: 1" = 400'

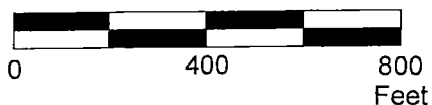

This map was prepared for the purpose of identifying the location of a water right only and is not intended to provide legal dimensions or location of property ownership lines.



Claim of Beneficial Use Map
Application G-16795, Permit G-16307

Jessica and Kevin Batugo
T.4S. R.2E. Sec. 31 & 32 and
T5S. R.2E. Sec. 5 & 6 W.M.

Pacific Hydro-Geology, Inc.

10/2023