


T5S, R3W WM, Section 7
Yamhill County, Oregon
Application S-72668 Permit S-54757

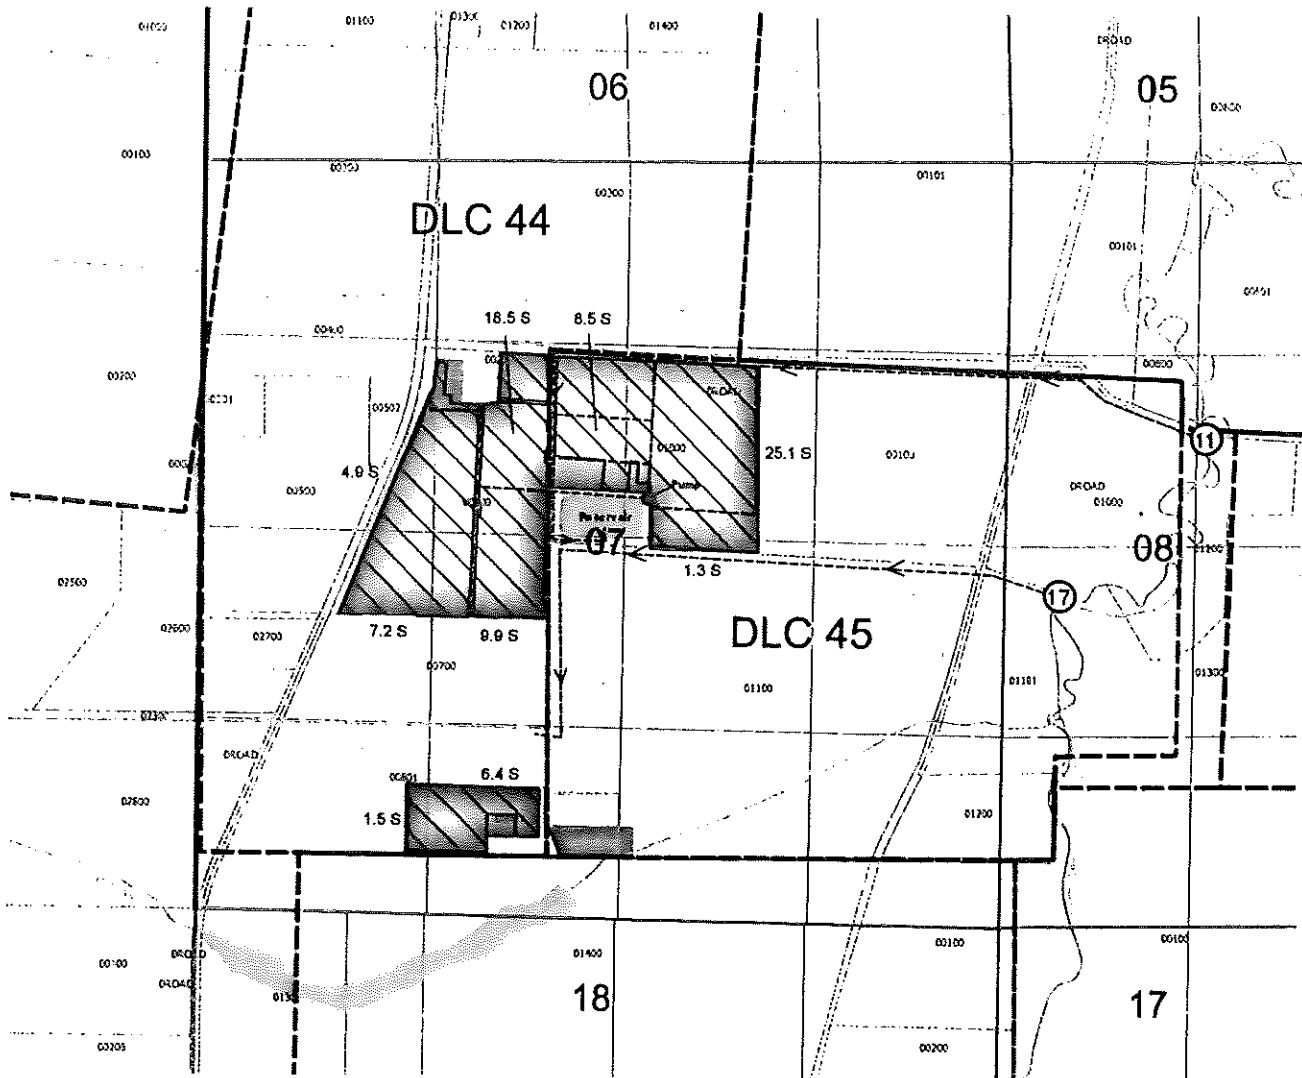

Explanation

- Rediversion (11 and 17)
- Mainline to Place of Use
- Nursery Operations (Primary = 94.2 Acres)
- Irrigation (Supplemental = 83.5 Acres)
- Donation Land Claim
- County Tax Lots
- Roads
- Streams




0 330 660 990 1320 ft

1 inch = 1,320 feet


NAD 1983 HARN
Datum of 1983
Prepared August 22, 2019

Sources: BLM CadNDSI PLSS, roads, county lines & tax lots
(Pacific Hydro-Geology), Oregon Spatial Data Library water
features, DLC lines, et al.

This map was prepared for the purpose of identifying the
location of a water right only and is not intended to provide
legal dimensions or locations of a property.

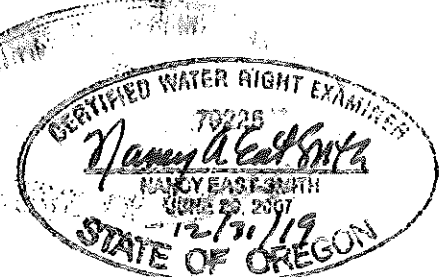

**T5S, R3W WM, Sections 4 & 5
Yamhill County, Oregon
Application S-72688 Permit S-54757**

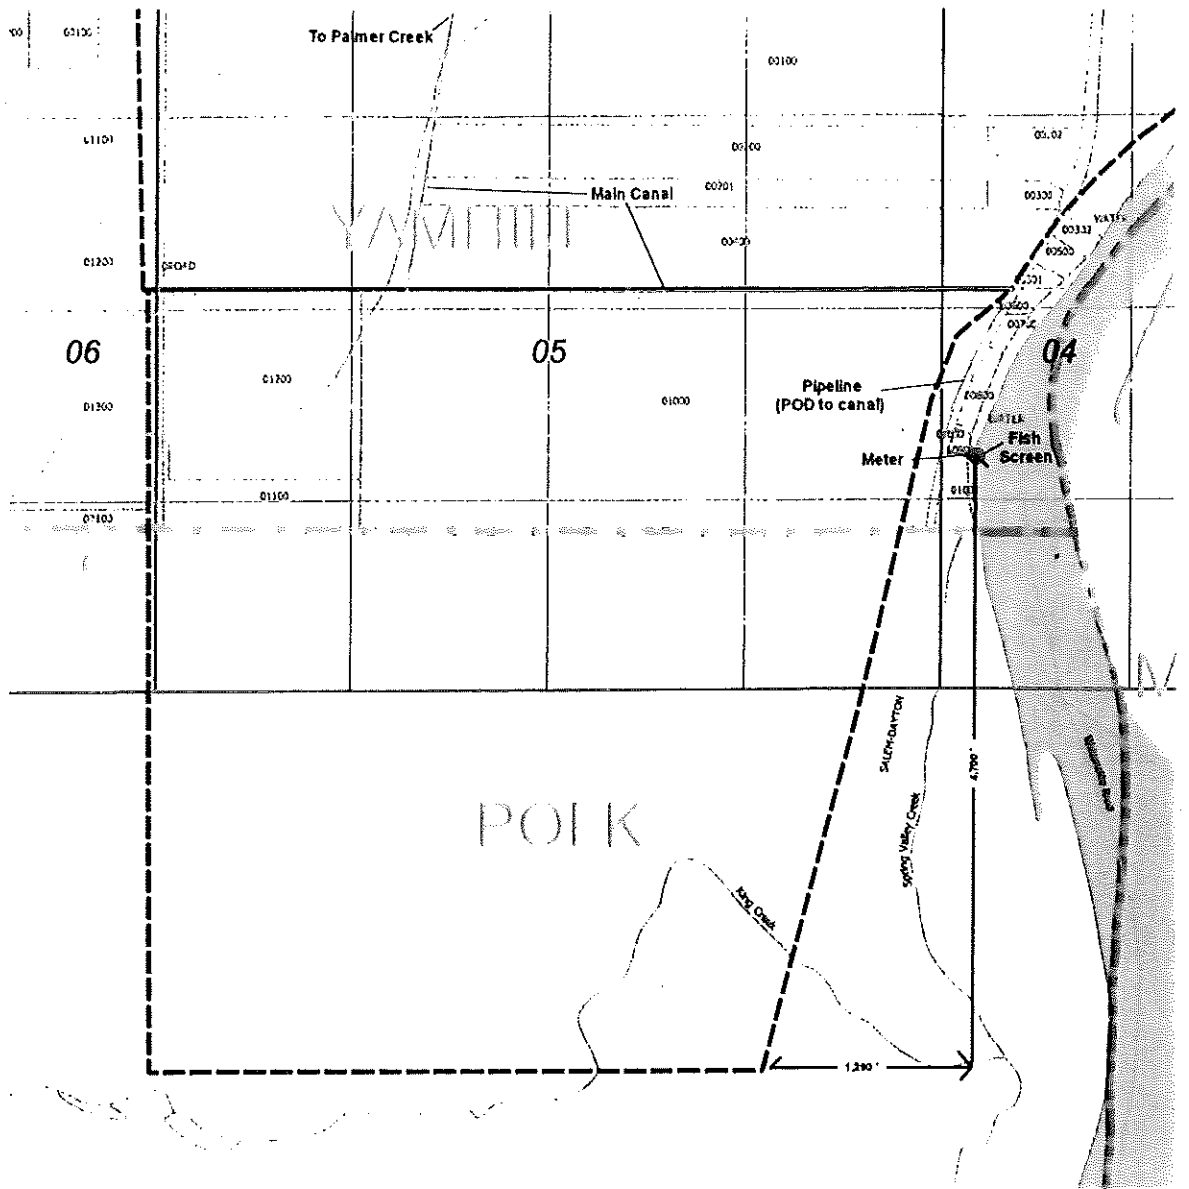

POD is located 4,700' N and 1,290' E from the SE corner of DLC 58, T6S, R3W, Sec. 4, NW 1/4 SW 1/4

0 330 660 990 1320 ft
1 inch = 1,320 feet

Explanation

- Point of diversion
- DLC
- Tax Lots
- Roads
- Streams

NAD 1983 HARN
Datum of 1983
Prepared August 21, 2019

Sources: BLH CadHSDI PLSS, roads, county lines & tax lots (Pacific Hydro-Geology), Oregon Spatial Data Library water features, DLC lines, et al. Locations of proposed diversions and points of use provided by client.

This map was prepared for the purpose of identifying the location of a water right only and is not intended to provide legal dimensions or locations of a property.

