


Revised

CLAIM OF BENEFICIAL USE MAP
FOR: PORTLAND V. A. MEDICAL CENTER
Assessor Legal: Sec.9 15 1E TL1600 27.58 AC
3710 S.W. Veterans Hospital Road,
Portland, Oregon, 97239
Application: G-17236
Permit: G-16701

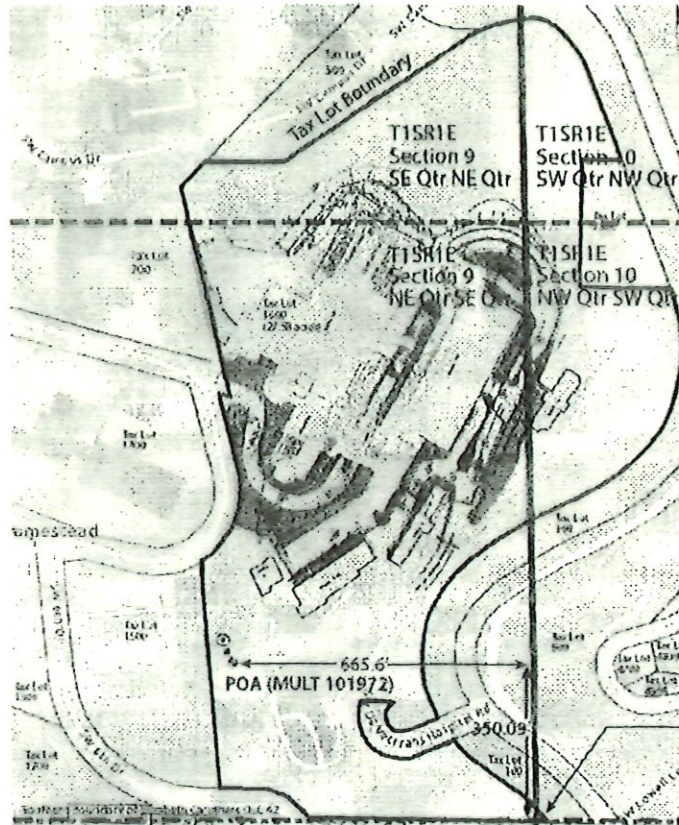

EXPIRATION DATE: 6-30-16

Note: The entirety of Tax Lot 1600 is located within the Elizabeth Caruthers DLC 42


Scale 1' = 400"

LEGEND	
	Irrigated Area (1.82 Acres in NE Qtr, SE Qtr Section 9, 0.15 Acres in NW Qtr, SW Qtr Section 10)
	Section Line
	Quarter Section Line
	Combined Quarter Quarter Section Line and Elizabeth Caruthers DLC 42 Southern Boundary Line
	POA Well Location (MULT 101972)
	97,000 gallon potable water tank
	2,200 gallon poly irrigation tank
	Water Meters #s 1, 2, & 3 in Well House With POA



Point of Appropriation: 350.09 feet North and 665.00 feet West of the SE Corner of the NE Quarter Quarter of the SE Quarter of Section 9, (T15 R1E) 45° 29' 41.73"N, 122° 41' 04.52"W

Disclaimer: This map is not intended to provide legal dimensions or locations of property ownership lines.

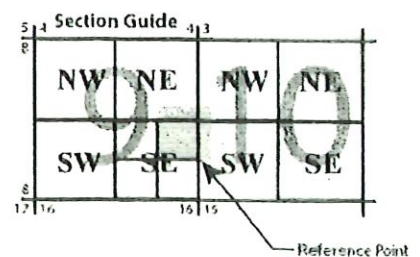

Resolved

AUG 14 2025

OWRD