


FINAL PROOF MAP

FOR PERMIT APPLICATION G-16597

JEFF MAUPIN

TOWNSHIP 24 SOUTH, RANGE 33 EAST, SECTION 36, W.M.

TAX LOT: 6903

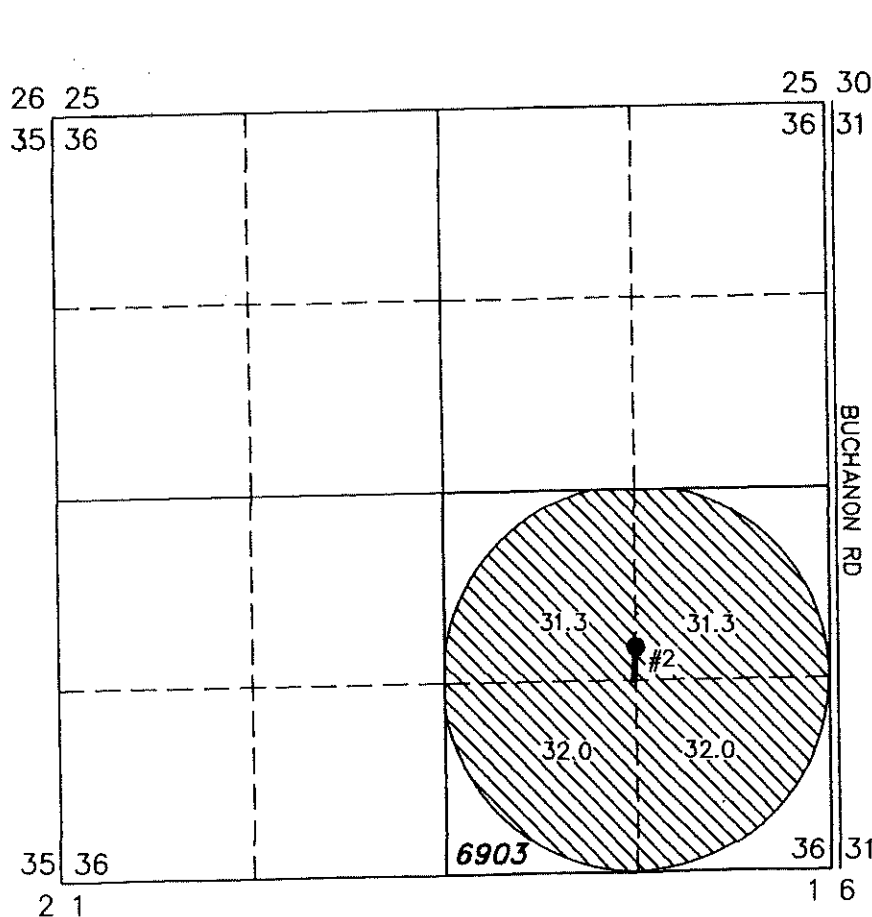

SCALE: 4 INCHES = 1 MILE

DECEMBER 11, 2012


NOV 19 2012

SALEM, OR

WELL 2

HARN 1050 LOCATED IN THE NW 1/4 SE 1/4 SECTION 36, T24S R33E, W.M. AND 1512 FEET NORTH AND 1356 FEET WEST FROM THE SE CORNER OF SECTION 36.

NEWLY INSTALLED METER IS APPROXIMATELY 7.5 FEET SOUTH ALONG DELIVERY PIPE FROM WELL.

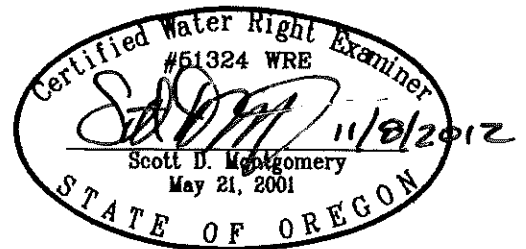

RENEWAL DATE: 12/31/2012



126.6 ACRES WATER RIGHTS FROM PERMIT G-16169, AS SHOWN.

THIS MAP IS FOR THE PURPOSE OF LOCATING A WATER RIGHT ONLY AND HAS NO INTENT TO PROVIDE LEGAL DIMENSIONS OR THE LOCATION OF PROPERTY LINES

PREPARED FOR:

JEFF MAUPIN
67477 SILVER CREEK RD.
RILEY, OR 97758

PREPARED BY:



ALL POINTS ENGINEERING AND SURVEYING, INC.
P.O. BOX 767 (CRR) TERREBONNE, OR 97760
(541) 548-5833
www.APEandS.com