

Claim of Beneficial Use Map Permit S-53529, Application S-83741

Water Right in the Name of Coquille Indian Tribe
Township 27 South, Range 14 West, Section 4 (W.M.)




Document Path: Y:\0533 Coquille Tribe\Source Figures\002 Water Rights\Claim of Use Permit S53529.mxd

LEGEND

- Point of Diversion (POD)
- Place of Use (POU)
- Water Mainline (Location Approximate)
- Tax Lot
- Watercourse, Perennial
- Watercourse, Intermittent
- Waterbody

POD LOCATION DESCRIPTION

POD 1: Located 238 feet South and 1,452 feet East from the W1/4 corner of Section 4, Township 27 South, Range 14 West (W.M.)
POD 2: Located 425 feet South and 2,030 feet East from the W1/4 corner of Section 4, Township 27 South, Range 14 West (W.M.)
POD 3: Located 484 feet North and 2,010 feet East from the W1/4 corner of Section 4, Township 27 South, Range 14 West (W.M.)

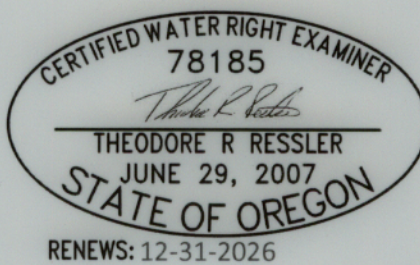


DISCLAIMER

This map was prepared for the purpose of identifying the location of a water right only and it is not intended to provide legal dimensions or location of property ownership lines.

MAP NOTES

Date: July 12, 2018
Data Sources: BLM, USGS, Coos Co, ESRI

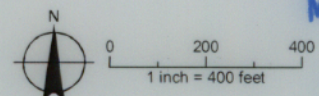

Received
MAY 19 2025
OWRD