
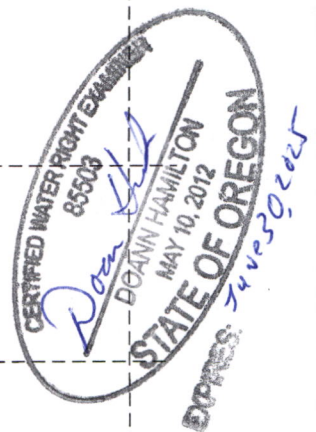



T.8S. R.2W. Section 1 T.8S. R.1W. Section 6, W.M.

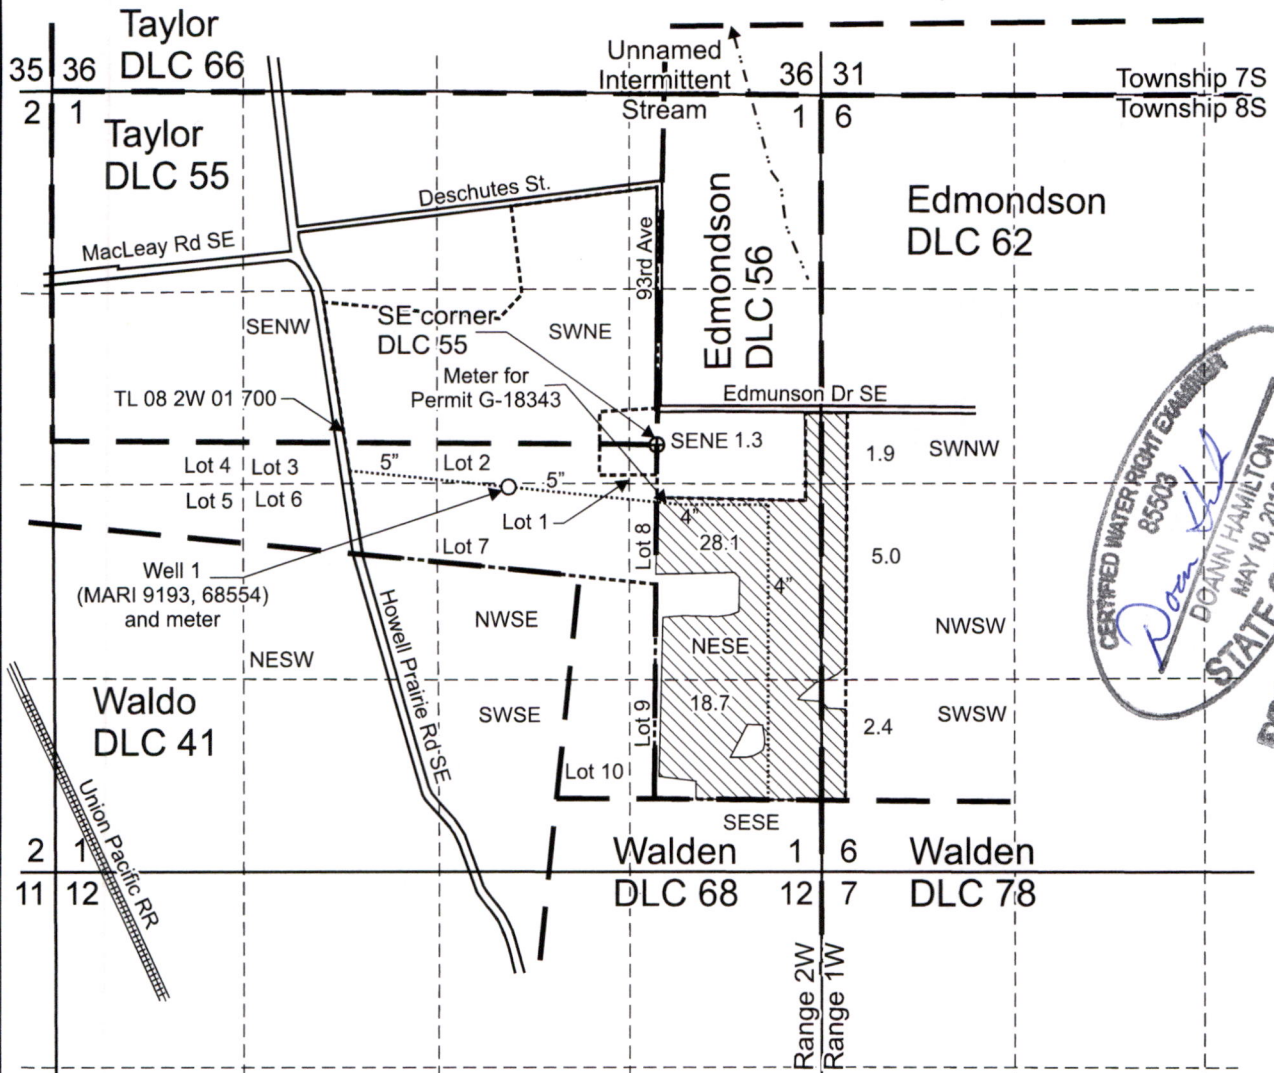

Well 1 (MARI 9193, 68554) is located 280 feet south and 1,020 feet west from the SE corner, DLC 55.

 Area (57.4 Acres) irrigated under Application G-18542, Permit G-18343.

----- Tax lot boundary

— • — Donation Land Claim boundary

..... Water main line

Scale: 1" = 1,320'



This map was prepared for the purpose of identifying the location of a water right only and is not intended to provide legal dimensions or location of property ownership lines.

Claim of Beneficial Use Map
Application G-18542, Permit G-18343

Beyer Farms
T.8S. R.2W. Section 1,
T.8S. R.1W. Section 6, W.M.

Pacific Hydro-Geology Inc.

07/2024

Received

JAN 23 2025

OWRD

