


# CLAIM OF BENEFICIAL USE MAP

TO CHANGE PLACE OF USE  
PER T-12644  
FOR SILVIES VALLEY RANCH, LLC

SECTION 36, TOWNSHIP 18 SOUTH, RANGE 31 EAST, W.M.  
TAX LOT 100 AND  
SECTION 1, TOWNSHIP 19 SOUTH, RANGE 31 EAST, W.M.  
TAX LOT 100

Received  
SEP 20 2024  
OWRD

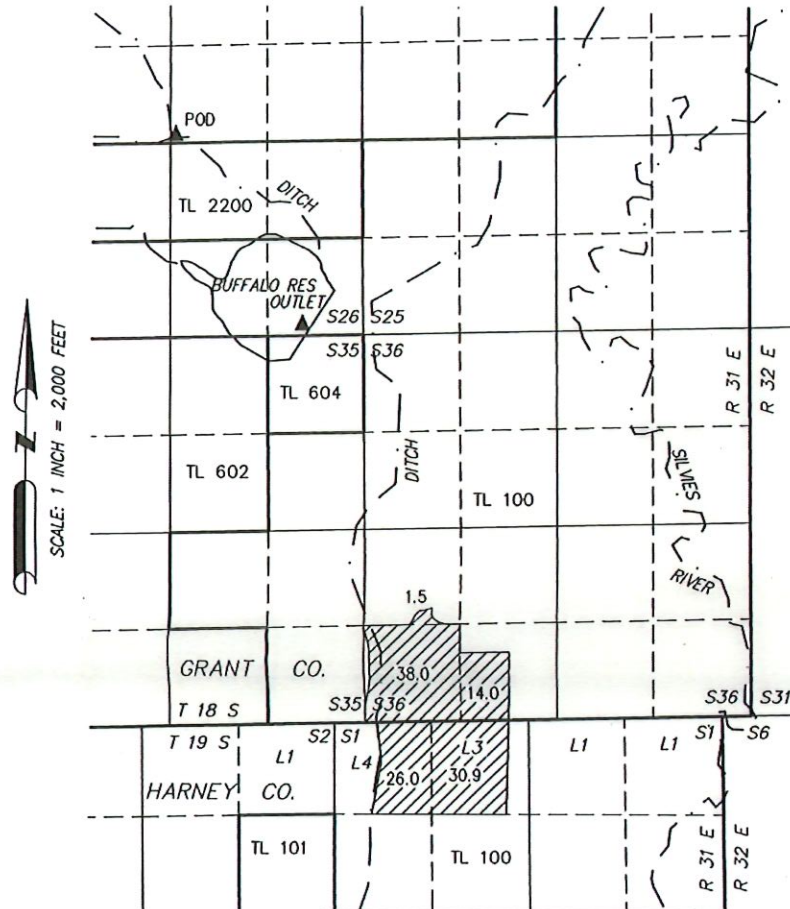

110.4 ACRES IS FROM T-12644  
(S-28501), AS SHOWN.

## ▲ OUTLET (BUFFALO RES)

AUTHORIZED POD IN THE SE 1/4 SE 1/4 SECTION 26,  
T18S R31E, W.M. LOCATED 280 FEET NORTH AND 810  
FEET WEST FROM THE SE CORNER SECTION 26.

MEASURING DEVICE IS NORTH OF THE OUTLET OF AN  
18-INCH CMP ALONG THE DOWNSTREAM FACE OF THE DAM.

## ▲ POD (AQUADUCT)

AUTHORIZED POD IN THE SW 1/4 NE 1/4 SECTION 26,  
T18S R31E, W.M. LOCATED 2850 FEET NORTH AND  
2600 FEET WEST FROM THE SE CORNER SECTION 26.

MEASURING DEVICE IS BETWEEN THE INLET OF TWO  
24-INCH CMP ALONG THE UPSTREAM EMBANKMENT.



RENEWAL DATE: 12/31/2024

THIS MAP IS FOR THE PURPOSE OF LOCATING  
A WATER RIGHT ONLY AND HAS NO INTENT TO  
PROVIDE LEGAL DIMENSIONS OR THE LOCATION  
OF PROPERTY LINES

PREPARED FOR:

SILVIES VALLEY RANCH, LLC  
40000 E COWBOY LANE  
SENACA, OR 97873

PREPARED BY:



ALL POINTS ENGINEERING AND SURVEYING, INC.  
P.O. BOX 767  
(541) 548-5833  
TERREBONNE, OR 97760  
www.APEandS.com