

CLAIM OF BENEFICIAL USE MAP

TRANSFER: T-11619,
SECTION 14, TOWNSHIP 4 SOUTH, RANGE 11 EAST,
WILLAMETTE MERIDIAN, WASCO COUNTY, OREGON.
SEPTEMBER, 2024

DISCLAIMER:
THIS MAP IS NOT INTENDED TO PROVIDE
LEGAL DIMENSIONS OR LOCATIONS OF
PROPERTY OWNERSHIP LINES.



EXP. 12/31/2024

SCALE: 1" = 400'
FOR 11"x17" SHEETS


DATE	
REVISION	
No.	1
DATE	09/17/24
DRAWING STATUS	CCPJ

H.A. MCCOY
REGISTERED PROFESSIONAL ENGINEER
No. 65686
Exp. 12/31/24
WASCO COUNTY, OREGON

PROJECT: SPORTSMAN'S PARK COBU
PROJECT LOCATION: WASCO COUNTY
CLIENT: SPORTSMAN'S PARK

SHEET TITLE:
CLAIM OF
BENEFICIAL USE
MAP

JOB NO. 24-117
DRAWN BY: AIC
DRAWING: WR1.0

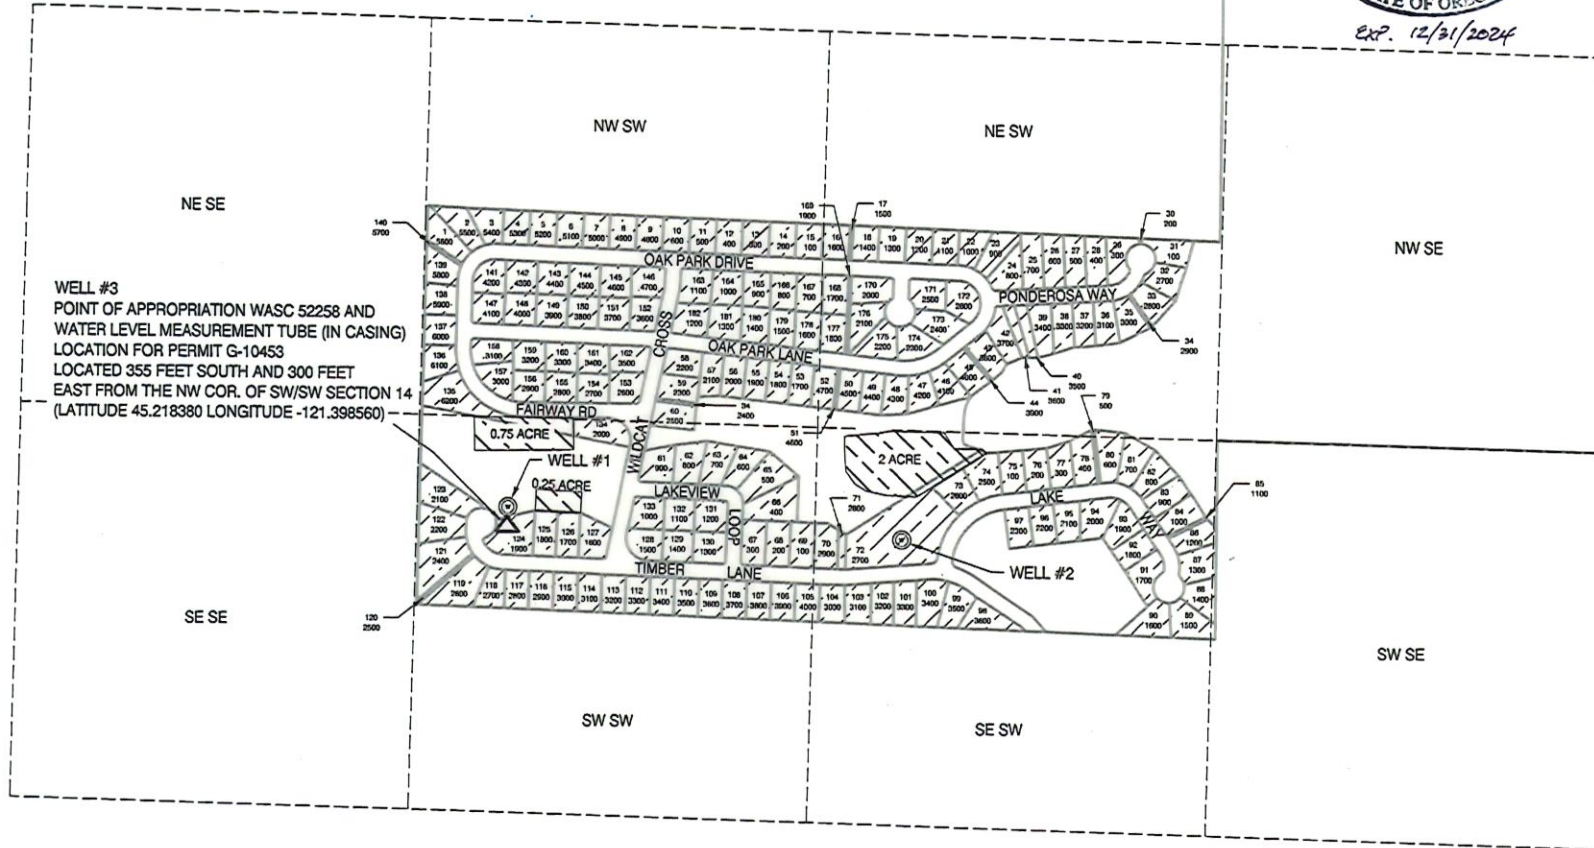

WELL #3
POINT OF APPROPRIATION WASC 52258 AND
WATER LEVEL MEASUREMENT TUBE (IN CASING)
LOCATION FOR PERMIT G-10453
LOCATED 355 FEET SOUTH AND 300 FEET
EAST FROM THE NW COR. OF SW/SW SECTION 14
(LATITUDE 45.218380 LONGITUDE -121.398560)

Received by OWRD
SEP 20 2024
Salem, OR

LEGEND

- SUPPLEMENTAL IRRIGATION AREA = 3.0 ACRES
- LOT / TAX LOT
- NEW POINT OF APPROPRIATION
- DOMESTIC USE FOR 142 FAMILIES, PERMIT G-10453 (PRIORITY 08/15/1984)