


# T.5S. R.3W. Sec. 8, 9, 16, & 17 W.M.

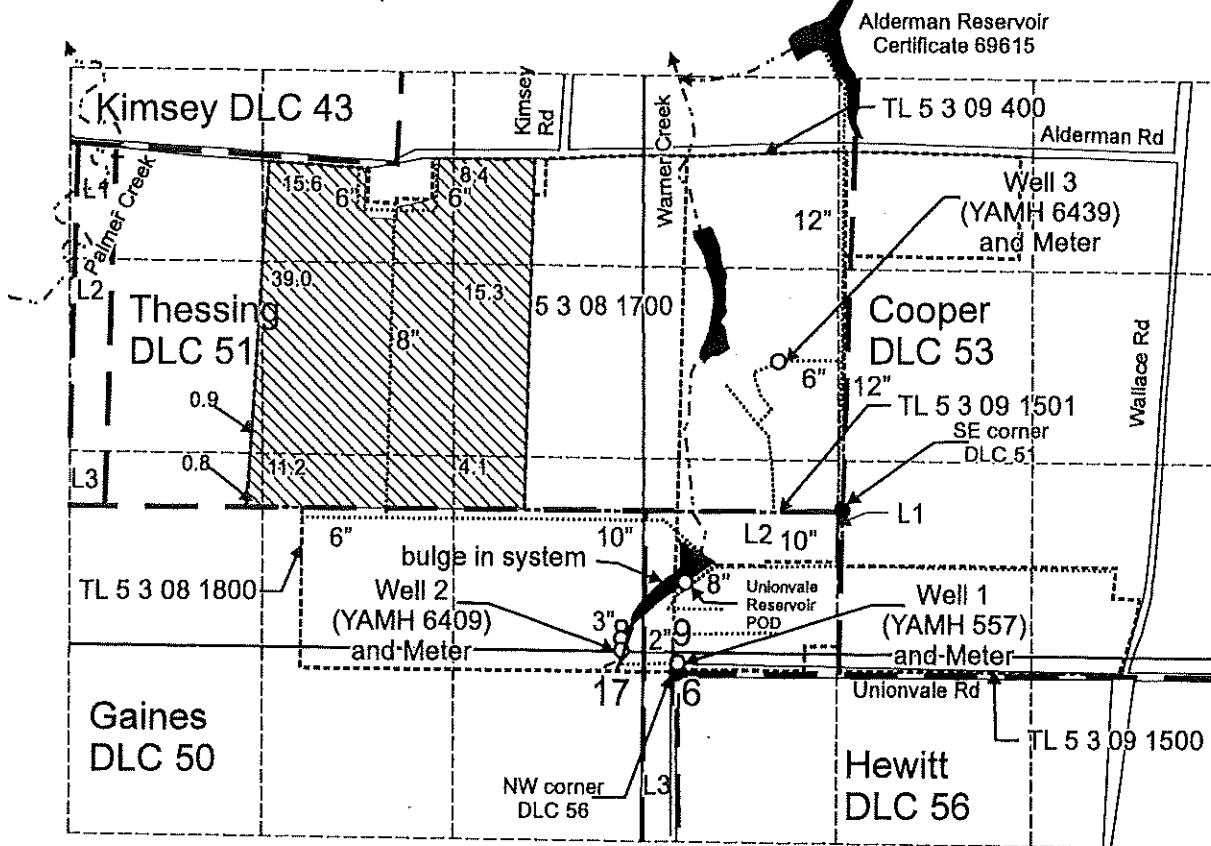

Well 1 (YAMH 557) is located 70 feet north and 5 feet east of the NW corner of DLC 56.

Well 2 (YAMH 6409) is located 150 feet north and 390 feet west of the NW corner of DLC 56.


Well 3 (YAMH 6439), is located 2,120 feet north and 680 feet east of the NW corner of DLC 56.

 Area (95.3 Acres) irrigated under Application G-15939, Permit G-17653.


- Tax lot boundary
- — — — — Donation Land Claim boundary
- ..... Water main line

Note: The quarter quarter lines have been projected using a tax map, government land survey maps, an aerial photograph, and best professional judgement.

Scale: 1" = 1,320'

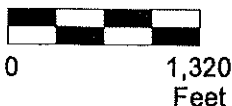

This map was prepared for the purpose of identifying the location of a water right only and is not intended to provide legal dimensions or location of property ownership lines.

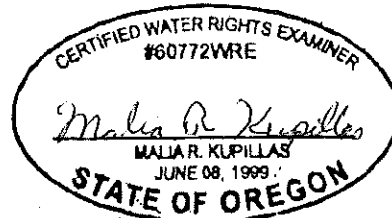

EXPIRATION DATE: 6/30/19

Pacific Hydro-Geology Inc.

12/2018

Claim of Beneficial Use Map  
Application G-17294 Permit G-17653

Carlton Nursery Company, LLC  
Newhouse/Finnicum Farm