


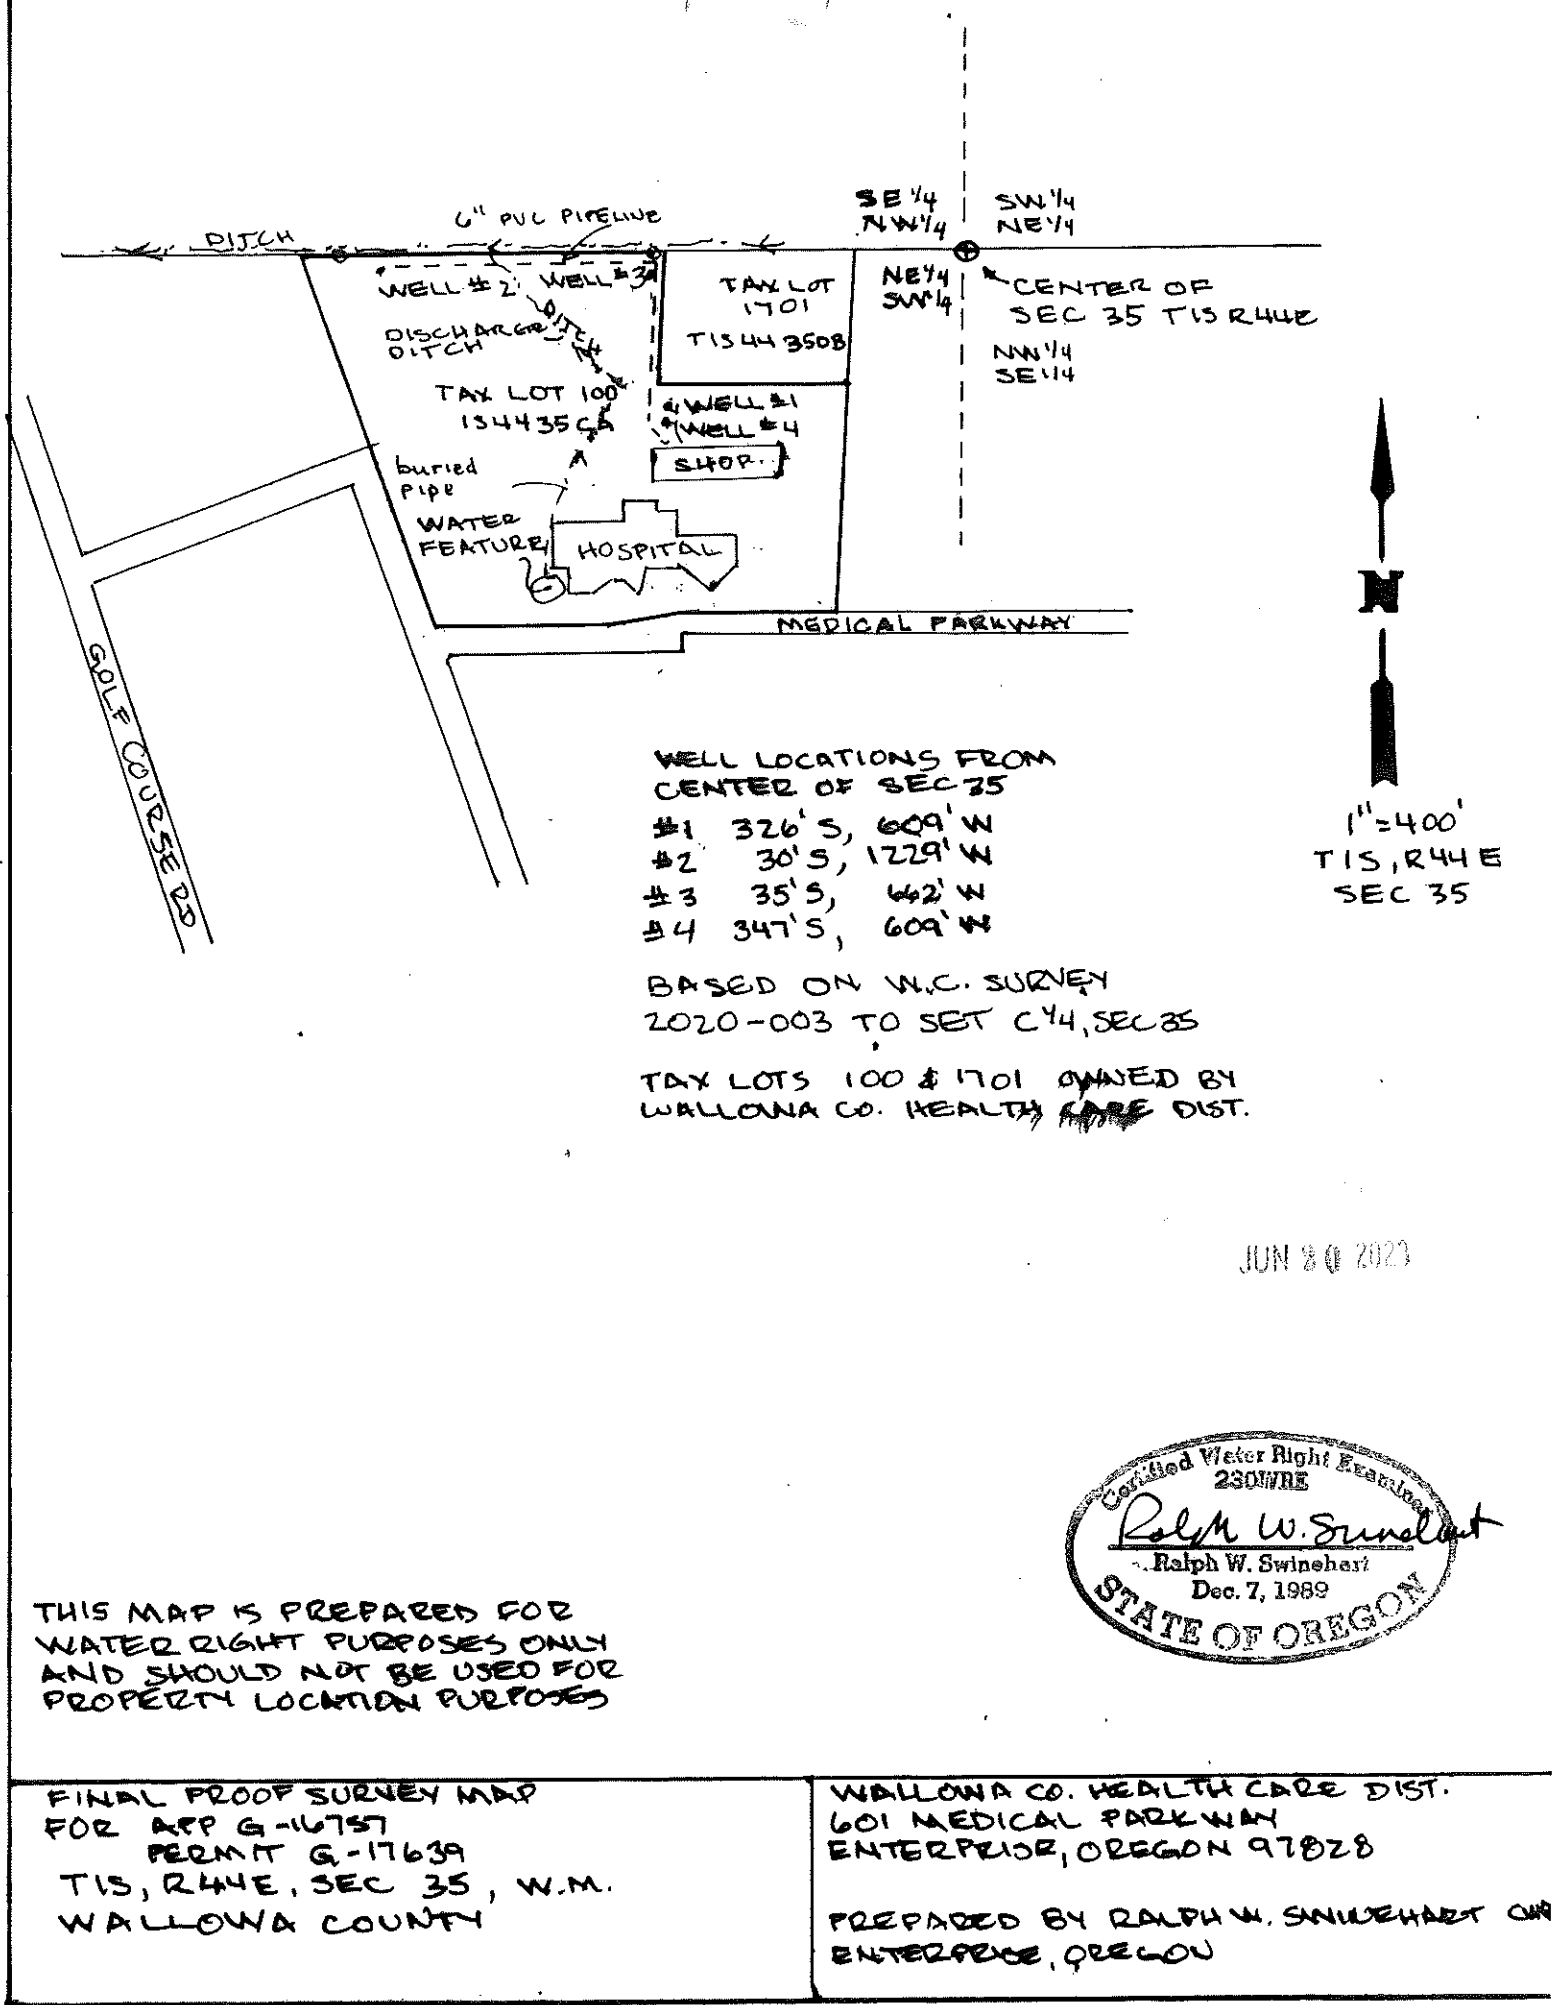

WELL LOCATIONS FROM
CENTER OF SEC 35

- #1 326' S, 609' W
- #2 30' S, 1229' W
- #3 35' S, 642' W
- #4 347' S, 609' W


BASED ON W.C. SURVEY
2020-003 TO SET C¹/₄, SEC 35

TAX LOTS 100 & 1701 OWNED BY
WALLONA CO. HEALTH CARE DIST.

1"=400'
T1S, R44E
SEC 35

JUN 20 2023

THIS MAP IS PREPARED FOR
WATER RIGHT PURPOSES ONLY
AND SHOULD NOT BE USED FOR
PROPERTY LOCATION PURPOSES

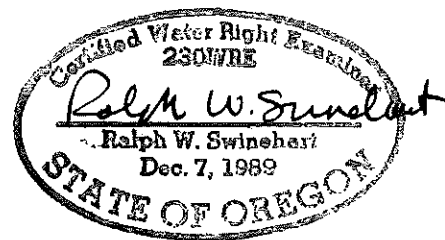

FINAL PROOF SURVEY MAP
FOR APP G-16757
PERMIT G-17639
T1S, R44E, SEC 35, W.M.
WALLONA COUNTY

WALLONA CO. HEALTH CARE DIST.
601 MEDICAL PARKWAY
ENTERPRISE, OREGON 97828

PREPARED BY RALPH W. SWINEHART CWR
ENTERPRISE, OREGON