

15155 Dunn Forest Road

T10S R5W S6 TL 213

RECEIVED

APR '06 2017

CATCHMENT POND 1


NORTH ↑

SALEM, OR

RECEIVED

OCT 10 2023

OWRD

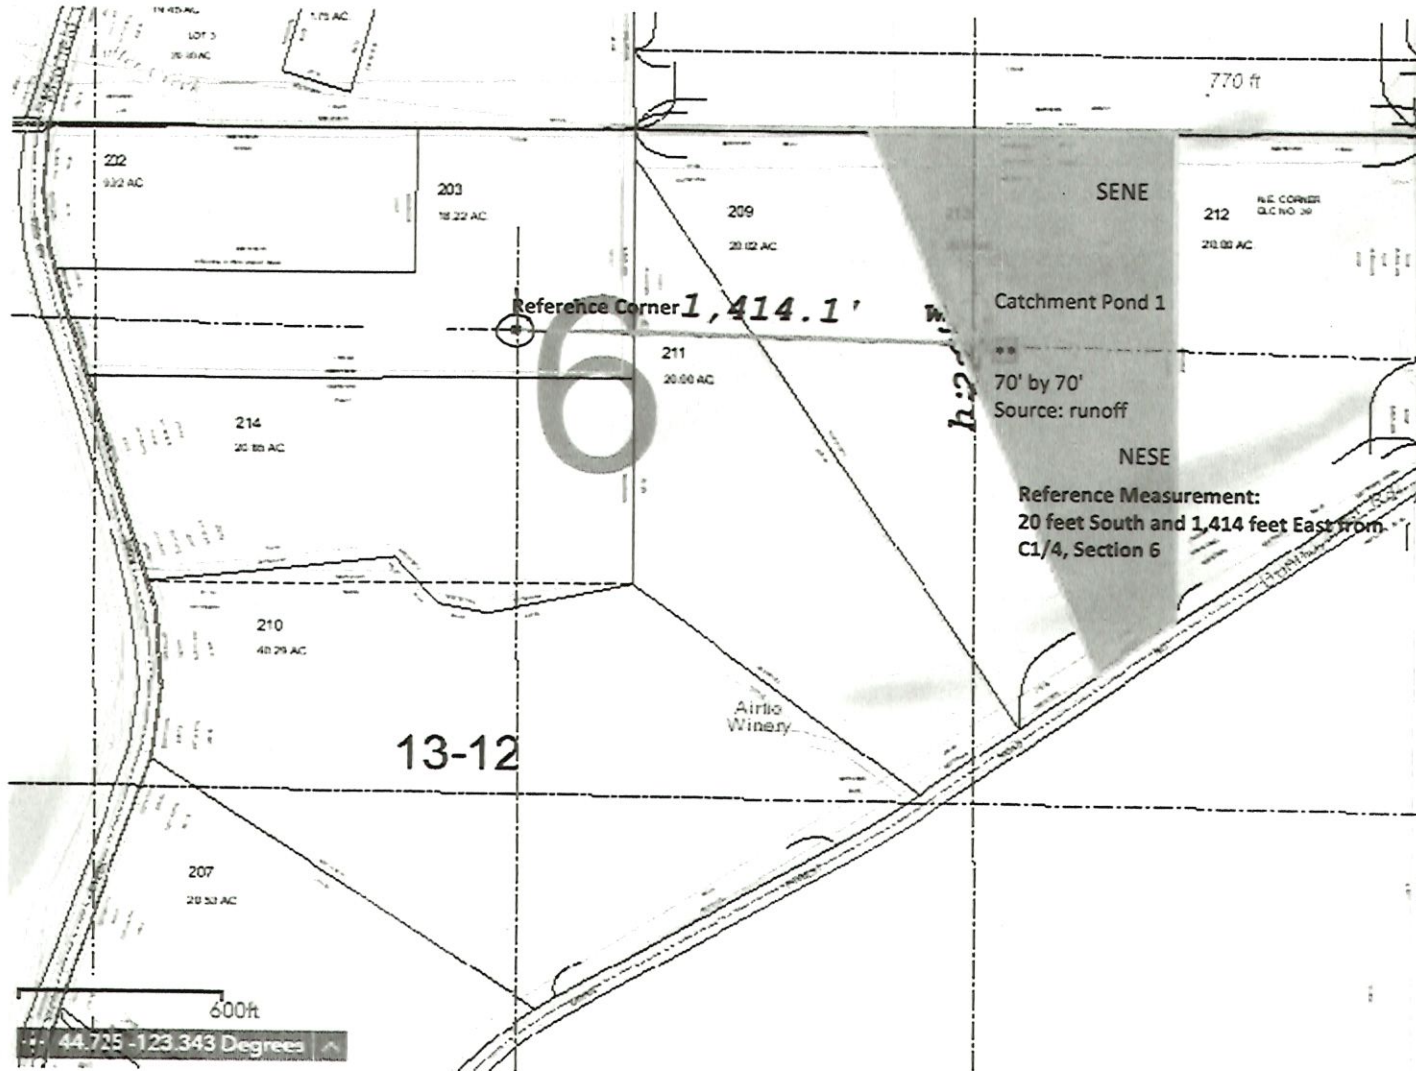

1" = 600 ft.

RECEIVED
OCT 30 2023
OWRD
SALEM, OREGON