


15155 Dunn Forest Road

T10S R5W S6 TL 213

CATCHMENT POND 2

NORTH ↑

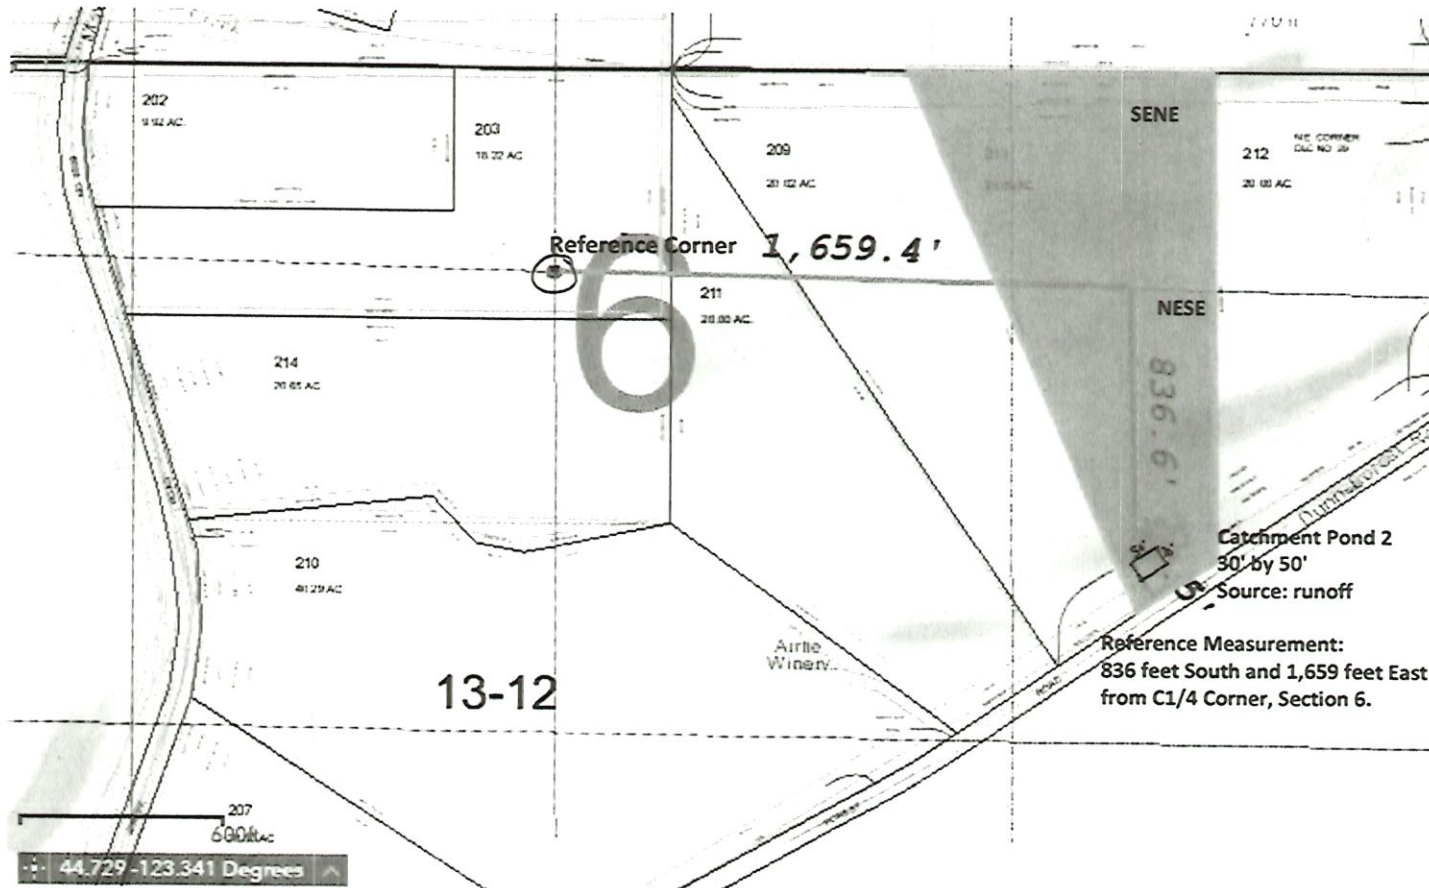

1" = 600 ft.

RECEIVED  
OCT 30 2023  
OWRD  
SALEM, OREGON

RECEIVED BY OWRD  
APR '06 2017  
SALEM, OR

RECEIVED  
OCT 10 2023  
OWRD

88488-7