

CLAIM OF BENEFICIAL USE MAP


TO ADD POINTS OF APPROPRIATION
PER APPLICATION T-11751
FOR MIKE PEILA


TOWNSHIP 24 SOUTH, RANGE 30 & 31 EAST, W.M.
TAX LOTS: 2100, 2101, 2200, & 3200
HARNEY COUNTY, OREGON

Received

AUG 28 2025

OWRD

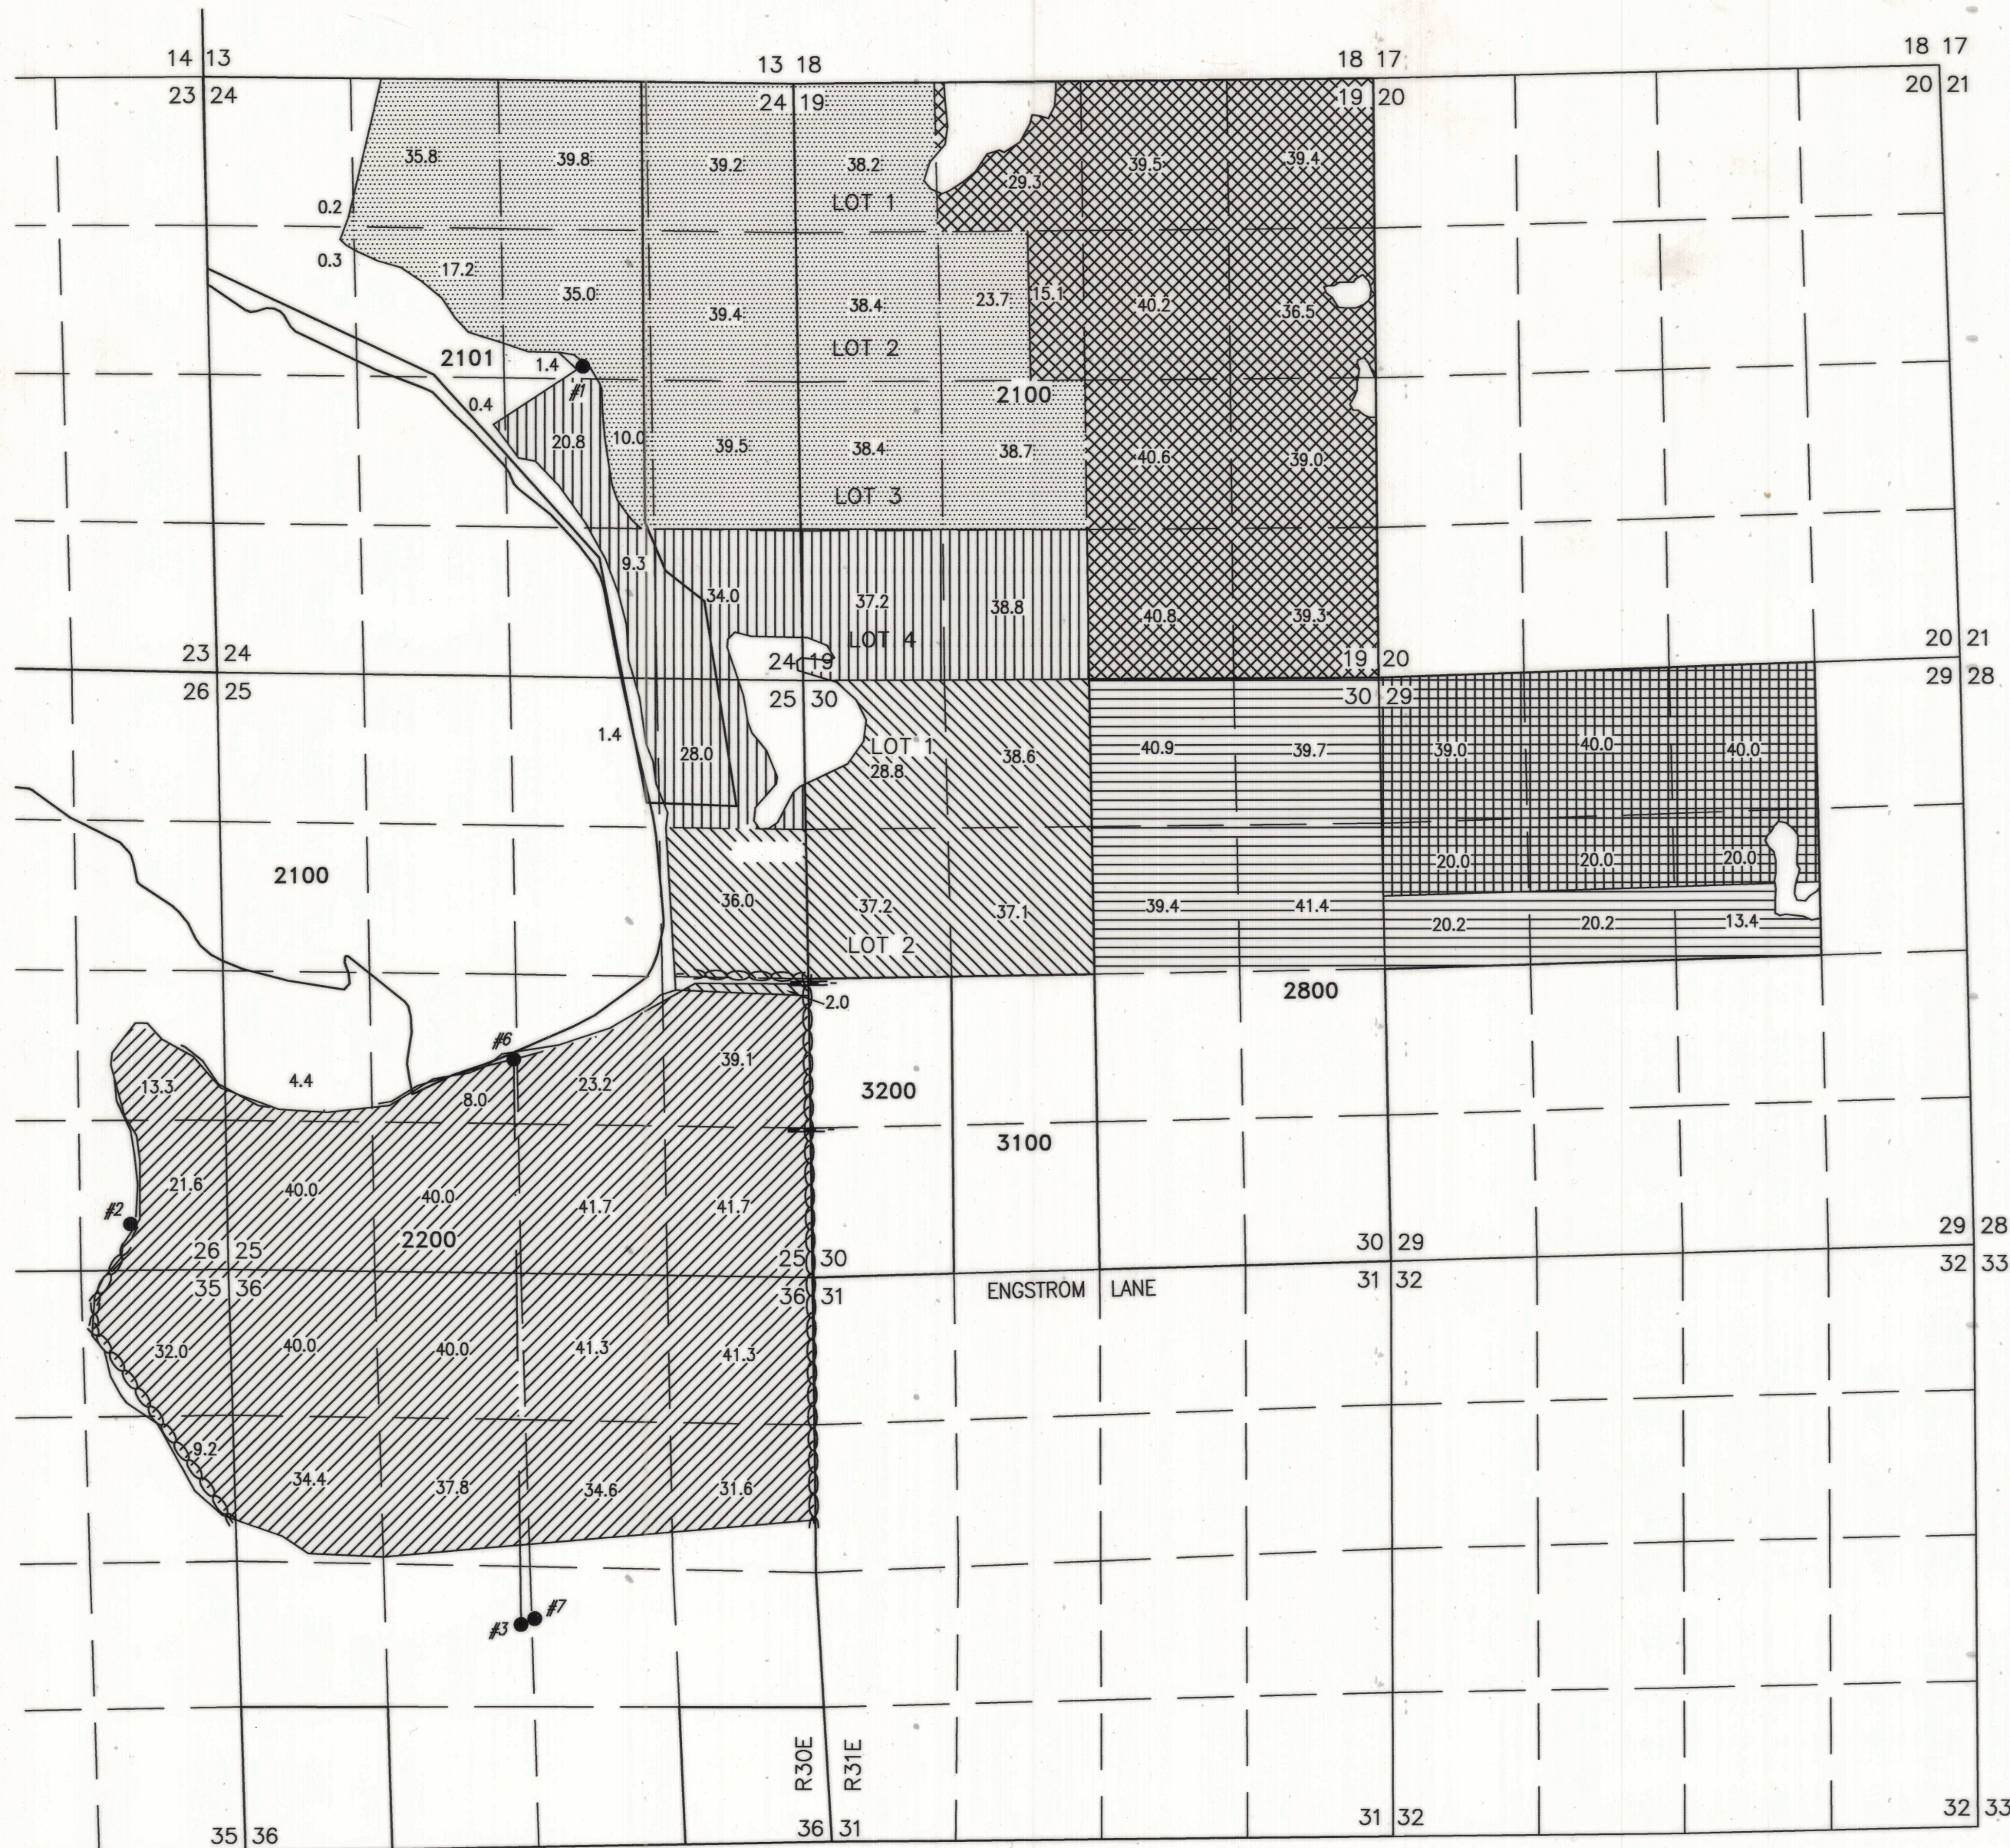

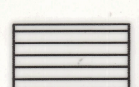-  WELLS 3, 6, & 7 TO EXISTING 171.3 ACRES IR FROM WELL 1 OF APPLICATION G-1797 & PERMIT G-1643, AS SHOWN.
-  WELLS 3, 6, & 7 TO EXISTING 179.7 ACRES IR FROM WELLS 1 & 2 OF APPLICATION G-1797 & PERMIT G-1643, AS SHOWN
-  WELLS 3, 6, & 7 TO EXISTING 433.8 ACRES IS FROM WELL 1 OF APPLICATION G-1797 & PERMIT G-1643, AS SHOWN. IR FROM SILVIE'S RIVER DECREE, V. 9, P. 79.
-  WELLS 3, 6, & 7 TO EXISTING 615.2 ACRES IR FROM WELL 2 OF APPLICATION G-1797 & PERMIT G-1643, AS SHOWN
-  WELLS 3, 6, & 7 TO EXISTING 215.2 ACRES IR FROM WELLS 1 & 2 OF APPLICATION G-5208 & PERMIT G-5073, AS SHOWN
-  WELLS 3, 6, & 7 TO EXISTING 179.0 ACRES IS FROM WELLS 1 & 2 OF APPLICATION G-5208 & PERMIT G-5073, AS SHOWN. IR FROM SILVIE'S RIVER DECREE, V. 9, P. 79.
-  WELLS 3, 6, & 7 TO EXISTING 359.7 ACRES IS FROM WELL 1 OF APPLICATION G-5208 & PERMIT G-5073, AS SHOWN. IR FROM SILVIE'S RIVER DECREE, V. 9, P. 79.

- **POA #1 (HARN 841/2)**
LOCATED IN THE SW 1/4 OF THE NE 1/4 OF SECTION 24, T24S, R30E, W.M. AND 2450' S & 630' W FROM THE E 1/16 CORNER BETWEEN SECTIONS 13 & 24.

FLOWMETER IS LOCATED ON THE DELIVERY PIPE 8 FEET WEST FROM THE WELL

- **POA #2 (HARN 844)**
LOCATED IN THE SE 1/4 OF THE SE 1/4 OF SECTION 26, T24S, R30E, W.M. AND 2270' S & 6160' W FROM THE E 1/4 CORNER SECTION 25.

FLOWMETER IS LOCATED ON THE DELIVERY PIPE 11 FEET SE FROM THE WELL

- **POA #3 (HARN 51332)**
LOCATED IN THE NE 1/4 OF THE SW 1/4 OF SECTION 36, T24S, R30E, W.M. AND 2000' N & 2525' E FROM THE SW CORNER SECTION 36.



FLOWMETER IS LOCATED ON THE DELIVERY PIPE 5 FEET NE FROM THE WELL

- **POA #6 (HARN 53133)**
LOCATED IN THE NE 1/4 OF THE SW 1/4 OF SECTION 25, T24S, R30E, W.M. AND 1955' N & 2685' W FROM THE SE CORNER SECTION 25.

FLOWMETER IS LOCATED ON THE DELIVERY PIPE 2 FEET SOUTH FROM THE WELL

- **POA #7 (HARN 52696)**
LOCATED IN THE NE 1/4 OF THE SW 1/4 OF SECTION 36, T24S, R30E, W.M. AND 2050' N & 2640' E FROM THE SW CORNER SECTION 36.

FLOWMETER IS LOCATED ON THE DELIVERY PIPE 6 FEET EAST FROM THE WELL

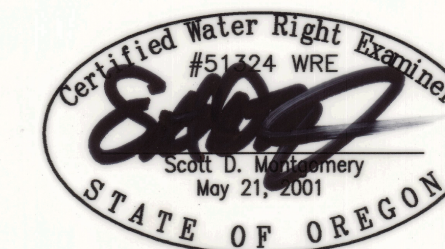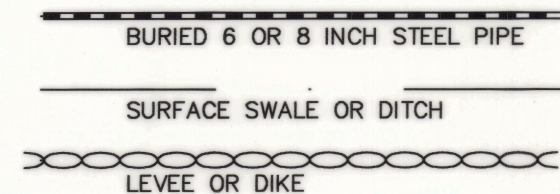

RENEWAL DATE: 12/31/2026

THIS MAP IS FOR THE PURPOSE OF LOCATING A WATER RIGHT ONLY AND HAS NO INTENT TO PROVIDE LEGAL DIMENSIONS OR THE LOCATION OF PROPERTY LINES

PREPARED FOR:

MIKE PEILA
P.O. BOX 537
HINES, OR 97738

PREPARED BY:

ALL POINTS ENGINEERING AND SURVEYING, INC.
P.O. BOX 767 TERREBONNE, OR 97760
(541) 548-5833 www.APEandS.com

