

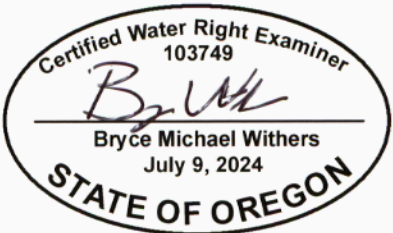


T26S R18E, WM,
LAKE COUNTY, OR

- Well & Meter
- POU IR Priority 7-10-1980
- POU IR Priority 2-20-1975
- Section
- Quarter Quarter
- Tax Lot

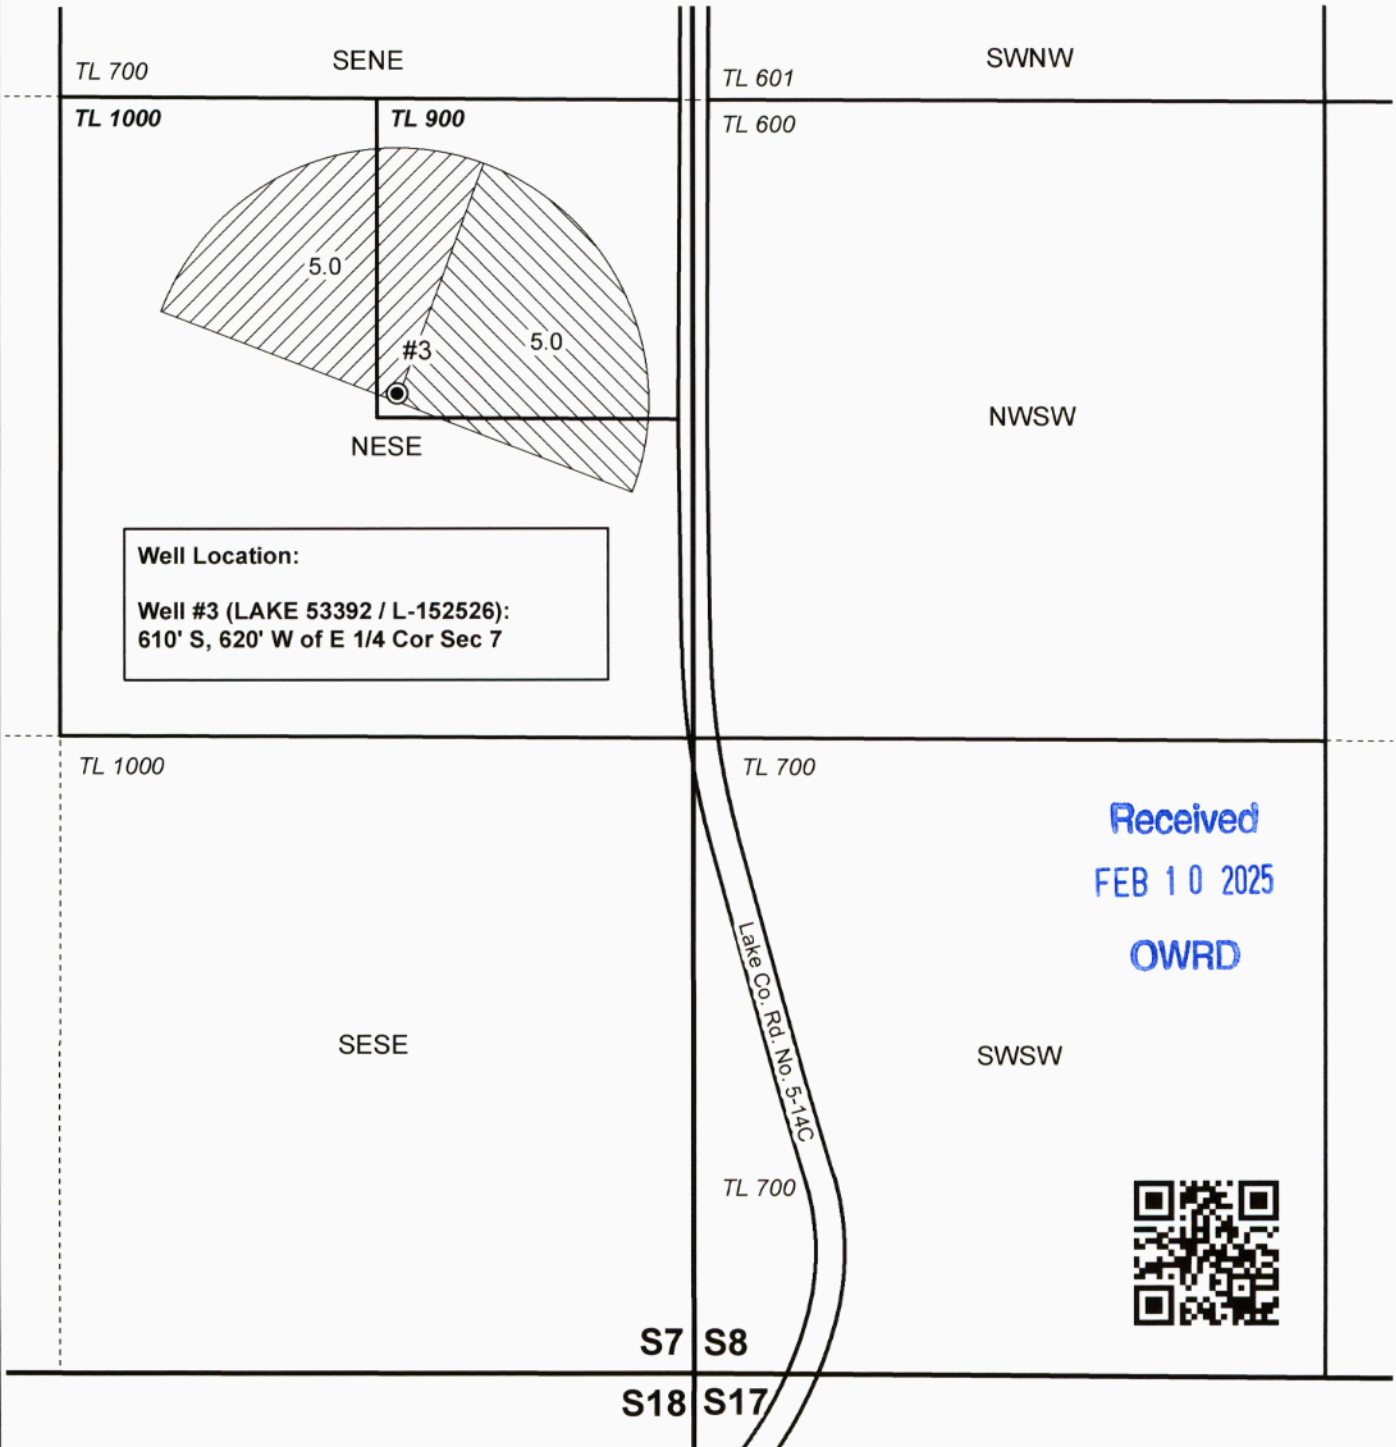

RENEWES: 06/30/2026

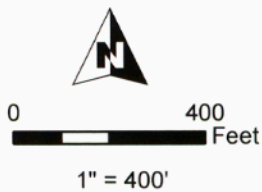

Received
FEB 10 2025
OWRD



CLAIM OF BENEFICIAL USE MAP
Warkentin Ranch

Date: 1/7/2025 T-13896

This map is not intended
to provide legal dimensions
or locations of property
ownership lines.

WATER RIGHT SERVICES, LLC
PO BOX 1830, BEND, OR 97709
WWW.OREGONWATER.US CCB # 197121
johnshort@usa.com 541-389-2837