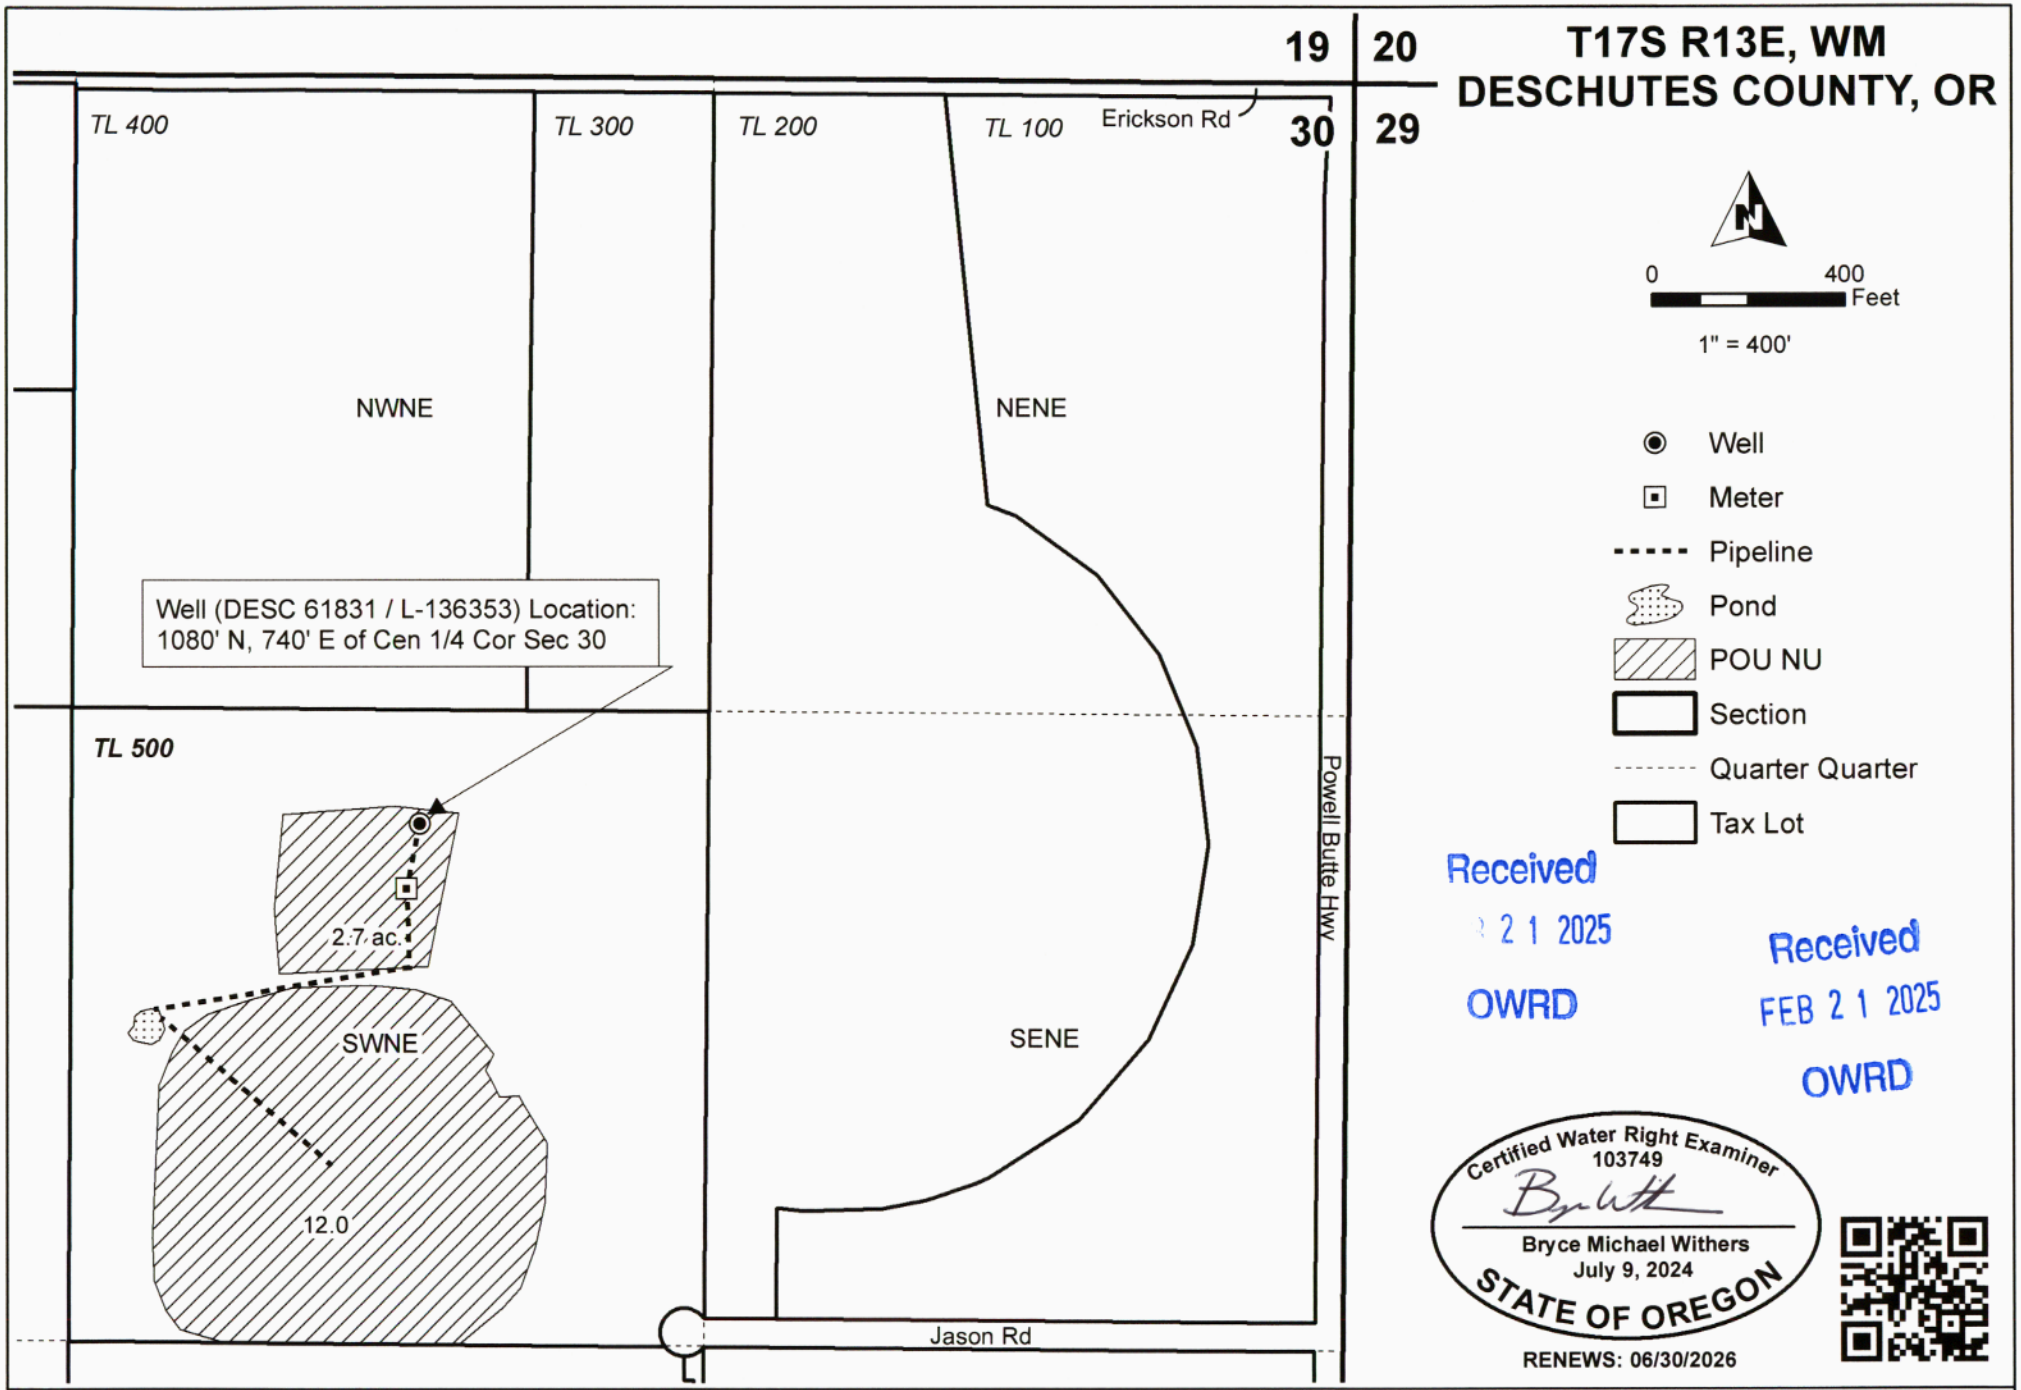

CLAIM OF BENEFICIAL USE MAP
TIORATI MGT LLC

Date: 2/10/2025 Ap G-18834 Permit G-18392

This map is not intended to provide legal dimensions or locations of property ownership lines.

WATER RIGHT SERVICES, LLC
PO BOX 1830, BEND, OR 97709
WWW.OREGONWATER.US CCB # 197121
johnshort@usa.com 541-389-2837